

STATION **TS 10293**
CASTLECRAG (Y9)

Owners-Name: **PUBLIC, RESERVE**

Current-Occupant:

Address


Address

Access **CLIMB UP ROCKS TO HIGHEST POINT IN RESERVE**

Not to Scale


Station Diagram

North

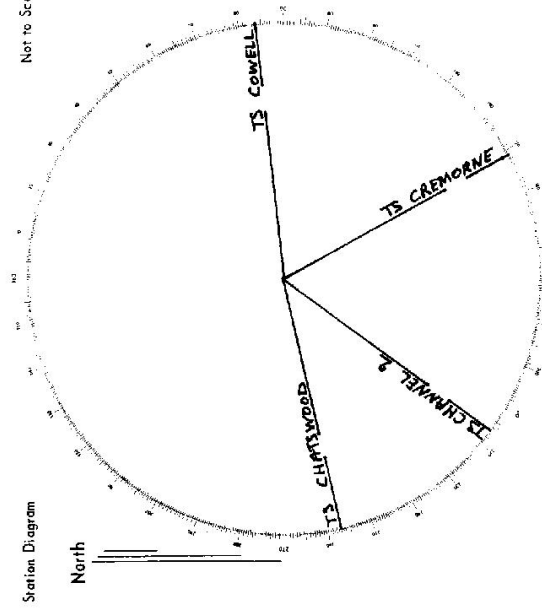

List of Observed Directions:-

Standpoint: STEEL PLUG		Station	Direction
TS CAEMORNE	157° 40' 48"		
TS CHATSWOOD	216° 41' 13"		
TS COWELL	256° 54' 18"		
	83° 16' 07"		
Station	Direction	Station	Direction
Station	Direction	Station	Direction

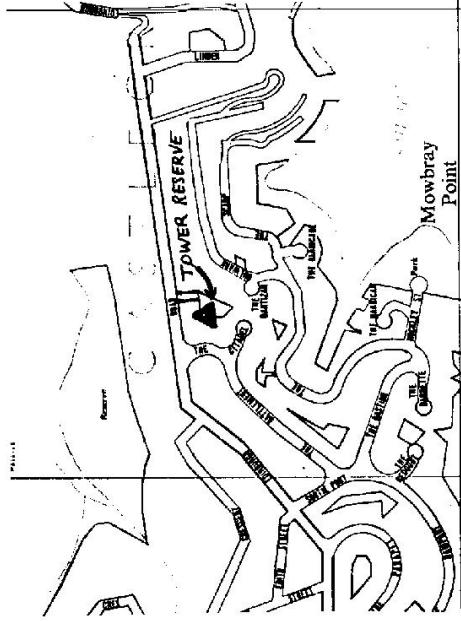

D. West, Government Printer, New South Wales - 1976

7-5-10-12

Department of Lands

Integrating survey of N.S.W.

RECONNAISSANCE and MAINTENANCE REPORT

This Trig. Station has been:

Note: Cross out word or words which do not apply

1. Completely cleared to permit 360° vision to surrounding Trigs.
2. Cleared by lances bearing..... from Trig. Mast
3. Trig. Mast & Vanes have been painted white & black respectively.
4. The Trig. was unpiled/not unpiled, dimensions now being:

Description of mark..... **STEEL PLUG IN ROCK** should be explicit, e.g. Steel plug, Brass plug, Bolt, Concrete Pillar

Height of mark..... **O.C.** m ^{above} / _{below} rock ~~concrete~~ m ^{above} / _{below} G.L.

Height of Top Vanes to Top Mark/Top pillar plate m Diameter of Vanes (vertical)..... m.

Height of Cairn..... m. Diameter of Cairn..... m.

Length of Mast..... m. (approximate if not unpiled)

5. A..... set in conc./rock has been placed/fd m. bearing °M from Trig. Mast/pillar
6. A..... set in conc./soil has been placed/fd m. bearing °M from Trig. Mast/pillar
7. A..... set in conc./soil has been placed/fd m. bearing °M from Trig. Mast/pillar
8. A..... set in conc./rock has been placed/fd m. bearing °M from Trig. Mast/pillar

9. Connection..... to..... : m. bearing..... °M

10. Connection..... to..... : m. bearing..... °M

11. Connection..... to..... : m. bearing..... °M

12. Connection..... to..... : m. bearing..... °M

13. Diff. Ht. is..... m. ^{above} / _{below}

14. Diff. Ht. is..... m. ^{above} / _{below}

15. Diff. Ht. is..... m. ^{above} / _{below}

16. Diff. Ht. is..... m. ^{above} / _{below}

Prepared by: **E. GAUGAIN** Checked:

STATION **TS 10293** **Castlecrag**

Co: **CUMBERLAND** Ph: **WILLOUGHBY**

Map Sheet: **MOSMAN 1:10000** No: **1852**

Inspected by: **E GAUGAIN** Date: **13-12-19**

Authority: **I. S. B.** Field Book: **1418**

Beacon Diagram Not to Scale

NO BEACON

ORIGINAL DRILL HOLE FOUND.

STEEL PLUG PLACED APPROXIMATELY

IN CENTRE. 16-10-73

Date Record of Station

Previously known as 'Y9'

STATION **TS 10293** CASTLEC 1G

Current Occupant.....

Address.....


Owners Name.....

Address.....

191-12-1979
Access U.B.D. 10th Cd. PAGE 42 MB


Station Diagram Not to Scale

North

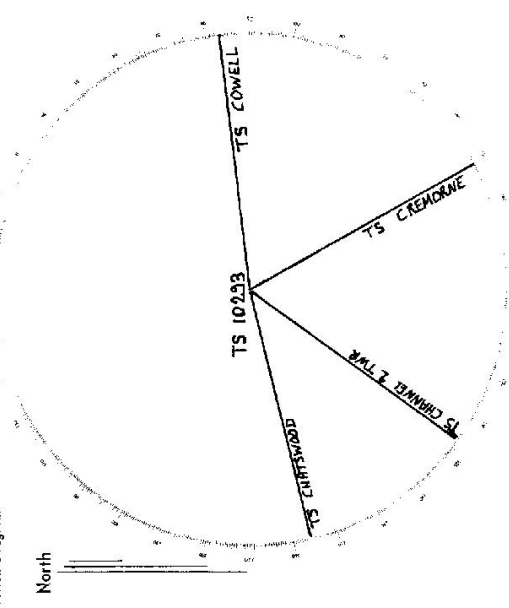

List of Observed Directions:-

Standpoint:		Station:	
Station	Direction	Station	Direction
TS CREMORNE	151° 00' 00"		
TS CHANNEL 2 TWR	216 44 28		
TS CHRISTWOOD	236 54 28		
TS COWELL	483 16 07		

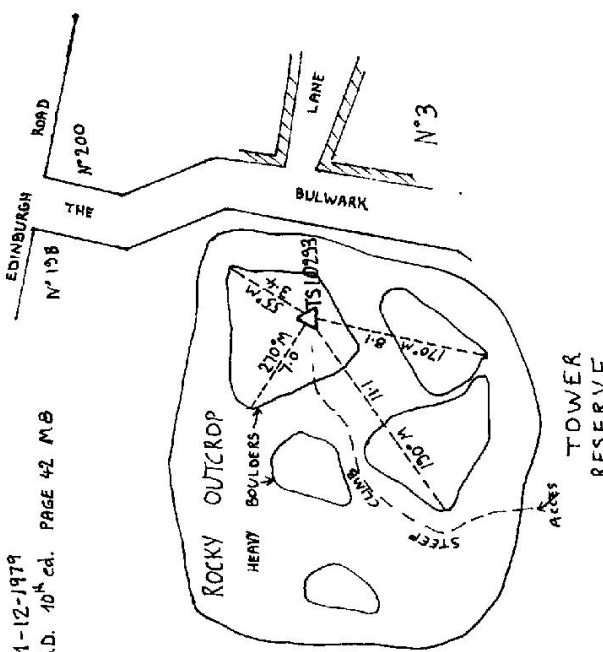

D. West, Government Printer, New South Wales - 1976