

75-103


Department of Lands
 Integration of N.S.W.
 RECONNAISSANCE and MAINTENANCE REPORT

STATION 75 10313 COOGERWILL (P)
 Co: COOK Ph: LETT
 Map Sheet: No:
 Inspected by: W. A. MARKS Date: DEC 76
 Authority: DEPT. OF LANDS Field Book: R. 766

This Trig. Station has been: Note: Cross out word or words which do not apply

1. Completely cleared to permit ~~best~~ vision to surrounding Trigs.
2. Cleared by lanes bearing from Trig. Mast
3. Trig. Mast & Vanes have been painted white & black respectively.
4. The Trig. ~~was completely re-erected~~, dimensions ~~now~~ being:
 Description of mark: ~~Concrete Pillar~~ should be explicit, e.g. Steel plug, Brass plug, Bolt, Concrete Pillar
 Height of mark: 1.23 m above ~~each~~/concrete ~~below~~ G.L. ~~1.23~~ m
 Height of Top Vanes to Top Mark/Top pillar plate: 0.73 m Diameter of Vanes (vertical): 0.25 m
 Height of Cairn: m Diameter of Cairn: m
5. A. ~~GP~~ set in conc./rock has been placed ~~at 2.800~~ m. bearing ~~110~~ from Trig. ~~Mast~~ pillar
6. A. ~~CS~~ set in conc./soil has been placed ~~at 2.788~~ m. bearing ~~201~~ from Trig. ~~Mast~~ pillar
7. A. set in conc./soil has been placed ~~at~~ m. bearing from Trig. Mast/pillar
8. A. set in conc./rock has been placed ~~at~~ m. bearing from Trig. Mast/pillar
9. Connection: to m. bearing M
10. Connection: to m. bearing M
11. Connection: to m. bearing M
12. Connection: to m. bearing M
13. Diff. Ht. ~~GP~~ is 1.042 m. ~~above~~ PILLAR RATE
14. Diff. Ht. ~~CS~~ is 1.213 m. ~~below~~ PILLAR RATE
15. Diff. Ht. is m. ~~above~~
16. Diff. Ht. is m. ~~below~~

Prepared by: *A. A. ...* Checked: *...*

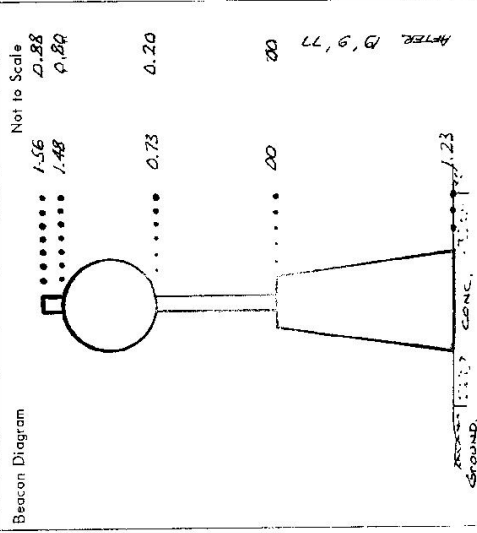

Date	Record of Station
18/12/76	PILLAR PLACED
21/7/77	TOP FOUND DESTROYED (MAST AND VANES)
18/9/77	NEW TOP PLACED

APRIL 18 '97
 AFTER 18 '97

