


This Trig. Station has been:-
 1. Completely cleared to permit 360° vision to surrounding Trigs.
 2. ~~Cleared by lower bearing~~
 3. Trig. Mast & Vanes have been painted white & black respectively.
 4. The Trig. was unpiled/not unpiled, dimensions now being:

Map Sheet: **NORTH SOLITARY ISLAND** No: **9538-11-5**
 Inspected by: _____ Date: _____
 Authority: _____ Field Book: _____

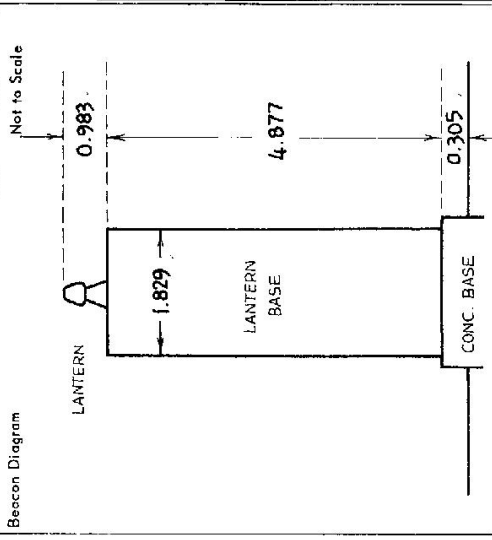

Note: Cross out word or words which do not apply

Description of mark: **Navigation Beacon** should be explicit, e.g. Steel plug, Brass plug, Bolt, Concrete Pillar

Height of mark: _____ m above rock/concrete _____ m below G.L.

Height of Top Vanes to Top Mark/Top pillar plate: _____ m Diameter of Vanes (vertical): _____ m.

Height of Cairn: _____ m. Diameter of Cairn: _____ m.

Length of Mast: _____ m. (approximate if not unpiled)

5. A. _____ set in conc/rock has been placed/fd _____ m. bearing _____°M from Trig. Mast/pillar

6. A. _____ set in conc/soil has been placed/fd _____ m. bearing _____°M from Trig. Mast/pillar

7. A. _____ set in conc/soil has been placed/fd _____ m. bearing _____°M from Trig. Mast/pillar

8. A. _____ set in conc/rock has been placed/fd _____ m. bearing _____°M from Trig. Mast/pillar

9. Connection: _____ to _____ m. bearing _____°M

10. Connection: _____ to _____ m. bearing _____°M

11. Connection: _____ to _____ m. bearing _____°M

12. Connection: _____ to _____ m. bearing _____°M

13. Diff. Ht. _____ is _____ m. above below

14. Diff. Ht. _____ is _____ m. above below

15. Diff. Ht. _____ is _____ m. above below

16. Diff. Ht. _____ is _____ m. above below

ERECTED BY DEPT. OF TRANSPORT

Date: _____ Record of Station: _____

Prepared by: **P. R. Edwards** Checked: **L. J. Griffin**

