

1:2500

Department of Lands Integral Survey of N.S.W.
RECONNAISSANCE and MAINTENANCE REPORT

This Trig. Station has been: Note: Cross out word or words which do not apply

1. Completely cleared to permit 360° vision to surrounding Trigs.
2. Cleared by lanes bearing 192° to 176° from Trig. Mast
3. Trig. Mast & Vanes have been painted white & black respectively.
4. The Trig. ~~was unlit~~ not unlit, dimensions now being:

Description of mark: Steel pillar should be explicit, e.g. Steel plug, Brass plug, Bolt, Concrete Pillar
 Height of mark: 1.24 m ^{above} ~~below~~ rect-concrete steel platform m ^{above} ~~below~~ G.L.
 Height of Top Vanes to Top-Mark/Top pillar plate: 1.44 m Diameter of Vanes (vertical): 9.9 m.
 Height of Cairn: m. Diameter of Cairn: m.
 Length of Mast: m. (approximate if not unlit)


5. A. set in conc/rock has been placed/fd m. bearing °M from Trig. Mast/pillar
6. A. set in conc/soil has been placed/fd m. bearing °M from Trig. Mast/pillar
7. A. set in conc/soil has been placed/fd m. bearing °M from Trig. Mast/pillar
8. A. set in conc/rock has been placed/fd m. bearing °M from Trig. Mast/pillar

9. Connection ~~Set~~ to m. bearing °M
10. Connection M.A. to m. bearing 247 °M
11. Connection H.V. to m. bearing 210 °M
12. Connection to m. bearing °M

13. Diff. Ht. is m. ^{above} ~~below~~
14. Diff. Ht. is m. ^{above} ~~below~~
15. Diff. Ht. is m. ^{above} ~~below~~
16. Diff. Ht. is m. ^{above} ~~below~~

Prepared by: [Signature] Checked:

STATION CULCAIRN (PTS 10332)
 Co: HUME | Ph: ROUND HILL
 Map Sheet: CULCARRA 1:25000 No:
 Inspected by: J. Eggleston Date: 18-11-10
 Authority: LANDS DEPT Field Book:

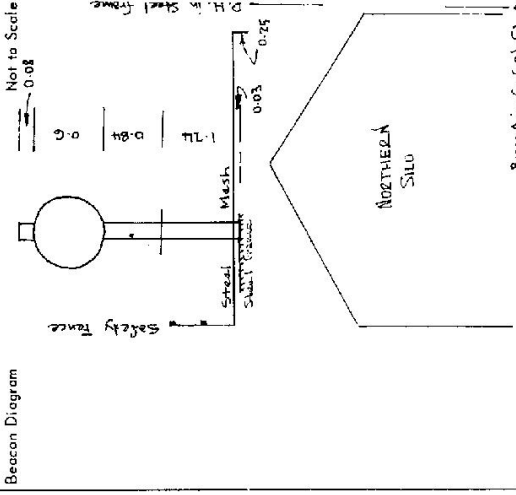

Beacon Diagram

Date	Record of Station
<u>18-11-10</u>	<u>Pillar erected</u>

Box Δ in Cont. at G.L.A

GEODETTIC SURVEY OF A.S.W.

CENTRAL MAPPING AUTHORITY

GEODETTIC STATION: RECONNAISSANCE and MAINTENANCE REPORT

Description:

1. Cleared by Janes bearing 197° - 178°.
Note: Cross out word or words which do not apply
..... from Trig. Mast
2. Mast & Vanes have been painted white & black respectively.
3. The station/pillar was unpiled/not unpiled on 18/10/89, dimensions now being:
Description of mark: 5 Pillar should be explicit, e.g. S/Steel Pillar Plate, Steel plug, Brass plug, Bolt, G.I. Pipe
Height of mark 1.74 m. ^{above} ~~from~~ feet/concrete Mark is m. ^{above} ~~below~~ G.L.
Height of Top Vanes to Top Mark/Pillar plate 1.44 m. Diameter of Vanes (vertical) 0.60 m.
Height of Cairn m. Diameter of Cairn m. Name Plate found/not found/placed.
Length of Mast 1.45 m. (approximate if not unpiled)
4. A set in conc/rock has been placed/found, bearing° M from Mast/Plug/Pillar
5. A set in conc/rock has been placed/found, bearing° M from Mast/Plug/Pillar
6. A set in conc/rock has been placed/found, bearing° M from Mast/Plug/Pillar
7. A set in conc/rock has been placed/found, bearing° M from Mast/Plug/Pillar
8. Action required:

STANDPOINT:

Mark	Direction	Horiz. Distance	Height Difference	Mark	Direction	Horiz. Distance	Height Difference
			above standpt				below standpt
			below standpt				above standpt
			above standpt				below standpt
			below standpt				above standpt
			above standpt				below standpt
			below standpt				above standpt
			above standpt				below standpt
			below standpt				above standpt
			above standpt				below standpt

Prepared by: J. Smith 2-7-89

Checked:

Named on U.T.M. Grid

STATION: CULCAIRN (1) TS No. 10332
 MAP SHEETS WRCGA WRCGA SCALE 1:100 000
 SCALE 1:250 000 HOLBROOK
 INSPECTED BY: J. Sutton DATE: 18.1.89
 AUTHORITY: CMA FIELD BOOK: -

Station Diagram

North
 Not to Scale


Checked

TS 27332-2 C. West Government Printer

STATION **CULCAIRN**) **TS - 10332**

Owner's Name **Grain Handling Authority**
 Address
 Phone
 Current Occupant:
 Address
 Phone

Access Report of 18/11/1976 was found suitable/unsuitable.

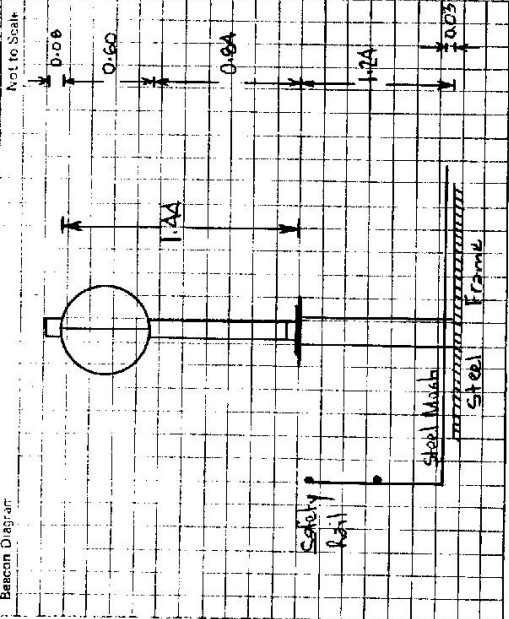

This section to be completed by officer constructing pillar.

Original station mark found/not found.

Description of mark:

Original beacon found/not found.

Description of beacon:

Height Top of Vanes to Top Markm.

Height of markm. above rock/contm. below G.L.

Diameter of Vanesm. Height of Cairnm.

Original Beacon has/has not been destroyed by me.

Date	Record of Station