



STATION **1 S HOWE (P) 10334**

Owners Name **Sutherland, Rosemary Col.**


Current Occupant **Sutherland, Rosemary Col.**

Address **Sydney**

Address **Sydney**

Not to Scale

Station Diagram

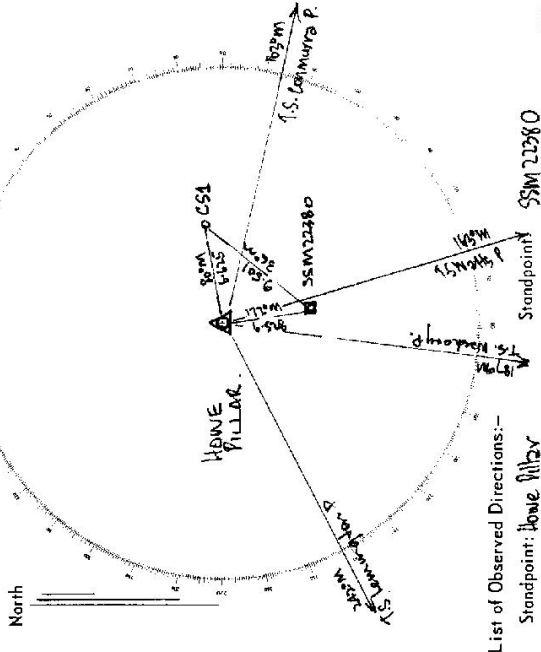

List of Observed Directions:-

Station	Direction	Station	Direction
1 S. Waals P.	0° 00' 00"	1 S. Howe P.	0° 00' 00"
SSM 2280	9° 11' 13"	CS1	44° 10' 30 S
1 S. Washery P.	25° 47' 55.17"		
1 S. Lemington P.	75° 21' 00.36"		
CS1	216° 43' 15.5"		
1 S. Conmurra P.	299° 21' 39.42"		

Access **15-2-1977**  
**Feature**  
 Sunbleton P.O. Travel Pully Road towards Sydney.  
 Turn Right at Denman - Jerrys Plains Rd.  
 Workworth Bridge  
 Turn Right at Maeson Drive Road.  
 Turn Left at T intersection  
 Pass turn off to Cheekhunt Hillon.  
 Left through Iron Gate - Castle Yendon on R.H.S.  
 Follow track to top of ridge - fence on R.H.S.  
 dam on L.H.S.  
**TRIA.**

Access by conventional vehicle in dry.