


75-103

Department of Lands
 Integration of N.S.W.
 RECONNAISSANCE and MAINTENANCE REPORT 10335
 STATION 15. CON MURRA (P) IS 10335

Co: HUNTER
 Map Sheet: CESSNOCK
 Inspected by: P.McBEATH
 Authority: I.S.D. NICLE
 No: 9132
 Date: 14.2.77
 Field Book: PDP 839

Beacon Diagram
 Not to Scale

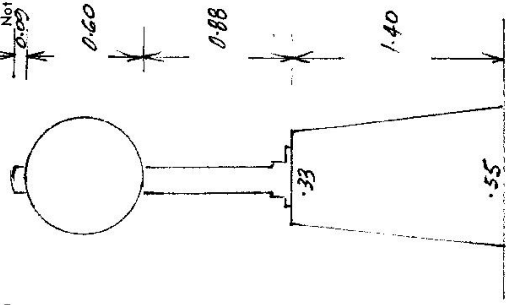

Date	Record of Station

This Trig. Station has been:
 Note: Cross out word or words which do not apply

- 1. Completely cleared to permit 360° vision to surrounding Trigs. ✓
- 2. Cleared by James bearing from Trig. Mast
- 3. Trig. Mast & Vanes have been painted white & black respectively. ✓
- 4. The Trig. was unpiled/ ~~replaced~~, dimensions now being:

Description of mark: concrete pillar should be explicit, e.g. Steel plug, Brass plug, Bolt, Concrete Pillar
 Height of mark: 1.40 ^{above} ~~below~~ rock/concrete 1.40 m ^{above} ~~below~~ G.L.
 Height of Top Vanes to ~~Top Mast~~ Top pillar plate: 1.48 m Diameter of Vanes (vertical): 0.60 m.
 Height of Cairn: 1.40 m. Diameter of Cairn: 0.33 / 0.55 m.
 Length of Mast: 1.57 m. (approximate if not unpiled)
 5. A SSM 23845 set in conc/~~rock~~ has been placed/~~at~~ 6.524 m. bearing 284 °M from Trig. Mast/pillar
 6. A C.S.I. set in conc/~~soil~~ has been placed/~~at~~ 5.723 m. bearing 16 °M from Trig. Mast/pillar
 7. A set in conc./soil has been placed/~~at~~ m. bearing °M from Trig. Mast/pillar
 8. A set in conc./rock has been placed/~~at~~ m. bearing °M from Trig. Mast/pillar
 9. Connection SSM 23845 to C.S.I. 9.803 m. bearing 64 °M
 10. Connection to m. bearing °M
 11. Connection to m. bearing °M
 12. Connection to m. bearing °M
 13. Diff. Ht. Wall Plate is 1.665 m. ^{above} ~~below~~ SSM 23845
 14. Diff. Ht. Wall Plate is 1.614 m. ^{above} ~~below~~ C.S.I.
 15. Diff. Ht. SSM 23845 is 0.055 m. ^{above} ~~below~~ C.S.I.
 16. Diff. Ht. is m. ^{above} ~~below~~
 Prepared by: PM Checked: PM

STATION T.S. NIMURRA (P) TS 10335

Current Occupant: Buchanan Borehole Coll.


Owners Name: Buchanan Borehole Coll.

Address: Sydney

Address: Sydney

- Access 14-2-1977
- Feature
 0-0 Singleton P.O. Travel Ruffy Rd towards Sydney
 Turn Right at Denman Rd. #.
 11.4 West north Bridge
 21.7 Turn Right at Mason Dieck Rd.
 23.2 Turn Right into Buchanan Borehole Borehole
 26.4 Pass Weighbridge on L.H.S.
 26.95 Turn Right around Sub-station
 27.15 Turn Right up hill.
 27.35 TRIG.
 27.65

Access by esplanatorial vehicle in dmd.

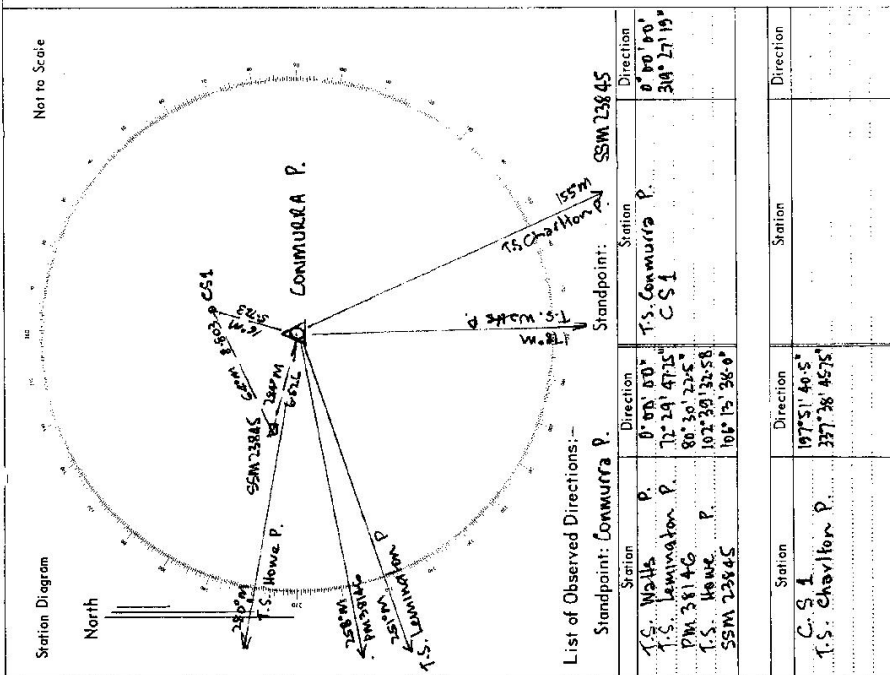

List of Observed Directions:-

Station	Direction	Station	Direction
T.S. Watts P.	0° 00' 00"	T.S. Commurra P.	0° 00' 00"
T.S. Levington P.	72° 29' 47.5"	C.S. I	310° 27' 19"
T.S. Howze P.	80° 30' 22.5"		
SSM 23845	102° 39' 32.58"		
	105° 15' 36.0"		

Station	Direction	Station	Direction
C.S. I	197° 51' 40.5"		
T.S. Charlton P.	337° 38' 45.75"		