


STATION T.S. WHERY (P) 10336

Owners Name *Sutherland Pty Ltd* Current Occupant *Sutherland Pty Ltd*

Address *Sydney* Address *Sydney*

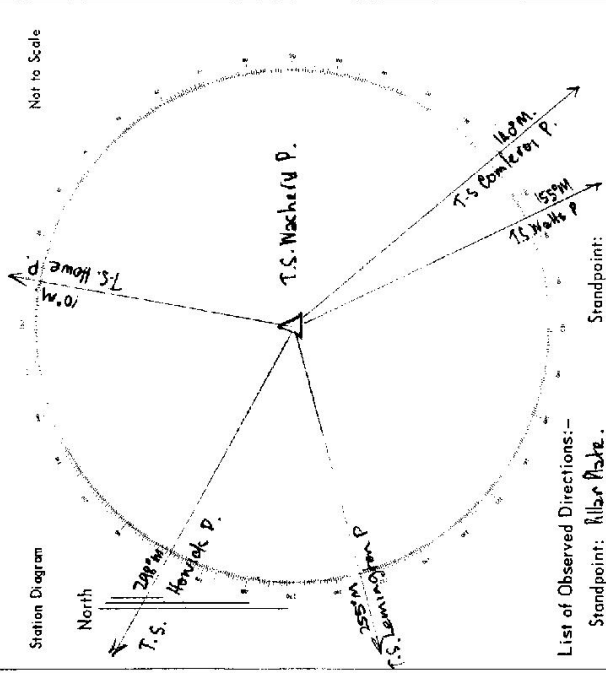

List of Observed Directions:-

Station	Direction	Station	Direction
T.S. Walsh P.	0° 00' 00"	T.S. Comber P.	
T.S. Lemington P.	99° 42' 20"	T.S. Walsh P.	
T.S. Howe P.	142° 42' 15"		
T.S. Howe P.	215° 07' 08"		
T.S. Comber P.	345° 20' 39"		

Access 14-2-1977

- 0-0. *Featule.*
- 11-1. *Smaleton P.O. Trived along fully road towards Sydney.*
- 21-7. *Turn Right onto Demman - Jerry's Point Rd.*
- 23-2. *Warkworth Bridge*
- 25-45. *Turn Right onto Mason Diele Road.*
- 26-45. *Turn Left into Adley and travel towards building complex.*
- 26-45. *Trig is on roof of Wshery - engine at office for access.*

Notes Conventional values in all sections