

75-103

Department of Lands Integrat Survey of N.S.W.
RECONNAISSANCE and MAINTENANCE REPORT

STATION TS 10338 FAIRWAY

This Trig. Station has been:-

Note: Cross out word or words which do not apply

Co: CUMBERLAND | PH: NARRARISEEN.
 Map Sheet: TERREY HILLS | No: 1567.
 Inspected by: F. Smith | Date: 1/5/74.
 Authority: M. S. J. D. P. | Field Book: TS 10338
 Beacon Diagram Not to Scale

1. Completely cleared to permit 360° vision to surrounding Trigs.
2. Cleared by fanes bearing from Trig. Mast
3. Trig. Mast & Vanes have been painted white & black respectively.
4. The Trig. was unpiled/not unpiled, dimensions now being: New station.

Description of mark..... should be explicit, e.g. Steel plug, Brass plug, Boli, Concrete Pillar

Height of mark..... m ^{above} rock, concrete _{below} G.L.

Height of Top Vanes to Top Mast/Top pillar plate..... m Diameter of Vanes (vertical)..... m.

Height of Cairn..... m. Diameter of Cairn..... m.

Length of Mast..... m (approximate if not unpiled)

5. A..... set in conc/rock has been placed/fd m. bearing°M from Trig. Mast/pillar
6. A..... set in conc/soil has been placed/fd m. bearing°M from Trig. Mast/pillar
7. A..... set in conc/soil has been placed/fd m. bearing°M from Trig. Mast/pillar
8. A..... set in conc/rock has been placed/fd m. bearing°M from Trig. Mast/pillar

9. Connection..... to..... m. bearing°M

10. Connection..... to..... m. bearing°M

11. Connection..... to..... m. bearing°M

12. Connection..... to..... m. bearing°M

13. Diff. Ht. is..... m. ^{above} _{below}

14. Diff. Ht. is..... m. ^{above} _{below}

15. Diff. Ht. is..... m. ^{above} _{below}

16. Diff. Ht. is..... m. ^{above} _{below}

Prepared by: P. YINCENT Checked:

Date	Record of Station



Lead plug in roof of house - no beacon

STATION TS 10338 FAIRWAY

Owners Name Current Occupant

Address Address

Access U8D MAP 17 F7 1974

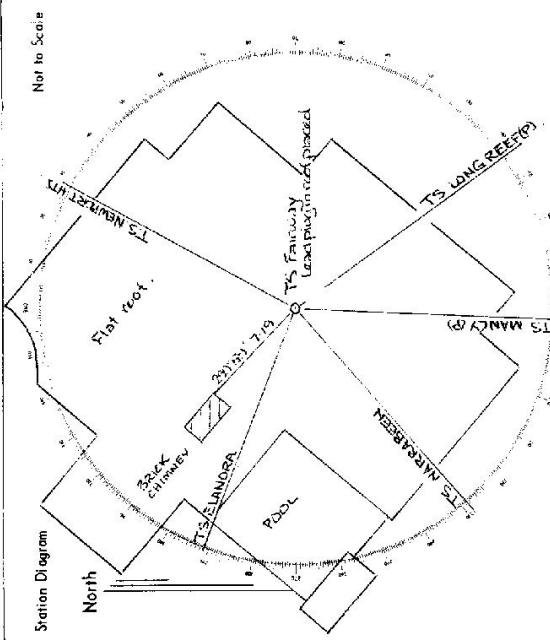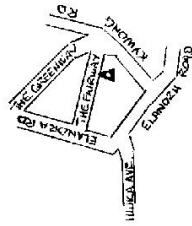

List of Observed Directions:—

Station	Direction	Station	Direction
TS NEWBERT HTS	287.46 52"		
TS LONG REEF (P)	143.93 42		
TS MANLY (P)	152.05 49		
TS MARA BUSH	228.85 17		
TS ELANDRA	251.05 21		

Station	Direction	Station	Direction

D. West, Government Printer, New South Wales - 1976