


75-193

Department of Lands Integrative Survey of N.S.W.  
**RECONNAISSANCE and MAINTENANCE REPORT**

STATION ST PATS C TOWN MAST TS 10349

Co: \_\_\_\_\_ PH: \_\_\_\_\_  
 Map Sheet: **CAMPBELLTOWN U8222** No: \_\_\_\_\_  
 Inspected by: **E.J. GARVIN** Date: **2.6.77**  
 Authority: **INTEGRATION** Field Book: **DP 598**  
 Beacon Diagram Not to Scale

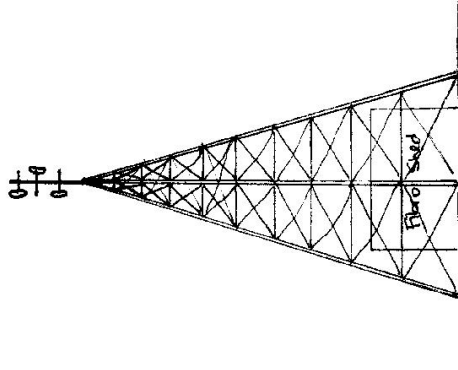

Date	Record of Station
2.6.77	Station connected

Note: Cross out word or words which do not apply

This Trig. Station has been:

1. ~~Completely cleared to permit 360° vision to surrounding Trig.~~
2. Cleared by lanes bearing ~~.....~~ from Trig. Mast
3. ~~Trig. Mast & Vanes have been painted white & black respectively.~~
4. The Trig. ~~was supplied/not supplied~~, dimensions now being:
  - Description of mark: **Galvanized Iron Rod in Mast** should be explicit, e.g. Steel plug, Brass plug, Bolt, Concrete Pillar  
 (Triangular, large base type)
  - Height of mark: ~~.....~~ <sup>above</sup> **40.0** m ~~below~~ G.L.
  - Height of Top Vanes to Top Mark/Top pillar plate: ~~.....~~ m Diameter of Vanes (vertical) ~~.....~~
  - Height of Cairn: ~~.....~~ m. Diameter of Cairn: ~~.....~~ m.
  - Length of Mast: ~~.....~~ m. (approximate if not supplied)

5. ~~S.M. 19928~~ set in conc/rock has been placed ~~at 20.817~~ **134** m. bearing ~~.....~~ °M from Trig. ~~Mast/pillar~~
6. ~~A.G.I. Pipe~~ set in ~~conc/soil~~ has been placed ~~at 27.071~~ **208** m. bearing ~~.....~~ °M from Trig. ~~Mast/pillar~~
7. A ~~.....~~ set in conc/soil has been placed ~~fd~~ **.....** m. bearing ~~.....~~ °M from Trig. Mast/pillar
8. A ~~.....~~ set in conc/rock has been placed ~~fd~~ **.....** m. bearing ~~.....~~ °M from Trig. Mast/pillar

9. Connection: ~~S.M. 19928 to G.I. Pipe~~ : ~~21.668~~ **246** m. bearing ~~.....~~ °M
10. Connection: ~~.....~~ to ~~.....~~ : ~~.....~~ m. bearing ~~.....~~ °M
11. Connection: ~~.....~~ to ~~.....~~ : ~~.....~~ m. bearing ~~.....~~ °M
12. Connection: ~~.....~~ to ~~.....~~ : ~~.....~~ m. bearing ~~.....~~ °M
13. Diff. Ht. ~~S.S.M. 19928~~ is ~~.....~~ **0.24** m. ~~above~~ <sup>below</sup> ~~.....~~ G.I. Pipe
14. Diff. Ht. ~~.....~~ is ~~.....~~ m. ~~above~~ <sup>below</sup> ~~.....~~
15. Diff. Ht. ~~.....~~ is ~~.....~~ m. ~~above~~ <sup>below</sup> ~~.....~~
16. Diff. Ht. ~~.....~~ is ~~.....~~ m. ~~above~~ <sup>below</sup> ~~.....~~

Prepared by: **Garvin 3.7.77** Checked: **Garvin**

**TS 10349 STATION ST PATS C'TOWN MAST TS 10349**

Current Occupant: St Bricks Girls School  
 Address: St John's Road  
 Access: Campanella Avenue

Owners Name: .....  
 Address: .....  
 Access: 2-6-1977

Check with Mother Superior before occupying.

