

Department of Lands
 Integrative Survey of N.S.W.
 RECONNAISSANCE and MAINTENANCE REPORT

This Trig. Station has been:-

Note: Cross out word or words which do not apply

1. Completely cleared to permit 360° vision to surrounding Trigs.
2. Cleared by ~~fences-bearing~~ from Trig-Mast
3. Trig. Mast & Vanes have been painted white & black respectively.
4. The Trig. was unpiled/~~not supported~~, dimensions now being:

Description of mark STEEL PLATE ON STEEL PILLAR should be explicit, e.g. Steel plug, Brass plug, Bell's Concrete Pillar
 Height of mark 0.6 m above rock/concrete 0.6 m below G.L.

Height of Top Vanes to ~~Top Mast~~ Top pillar plate 1.225 m Diameter of Vanes (vertical) 0.6 m.

Height of Cairn 0 m. Diameter of Cairn 0 m.

Length of Mast 1.385 m. (approximate if not unpiled)

5. ^{COPPER} A. ~~SPRUE~~ set in conc/rock has been placed 3.025 m. bearing 310 °M from Trig. ~~Mast~~ pillar
6. A. G.I. PIPE set in conc/~~soil~~ has been placed fd 0.308 m. bearing 211 °M from Trig. Mast/pillar
7. A. set in conc/soil has been placed fd m. bearing °M from Trig. Mast/pillar
8. A. set in conc/rock has been placed fd m. bearing °M from Trig. Mast/pillar

9. Connection to m. bearing °M
10. Connection to m. bearing °M
11. Connection to m. bearing °M
12. Connection to m. bearing °M

13. Diff. Ht. COPPER SPRUE is 1.816 m. ^{above}/_{below} PILLAR PLATE

14. Diff. Ht. G.I. PIPE is 1.005 m. ^{above}/_{below} PILLAR PLATE

15. Diff. Ht. is m. ^{above}/_{below}

16. Diff. Ht. is m. ^{above}/_{below}

Prepared by: B.J. MITCHELL Checked:

STATION T.S. 10352 PILLAS (P)


Co: Pte: MUNBARLD

Map Sheet: No: 10352

Inspected by: BRIAN MITCHELL Date: JULY 1977

Authority: DEPT. OF MAIN ROADS Field Book:

Beacon Diagram Not to Scale

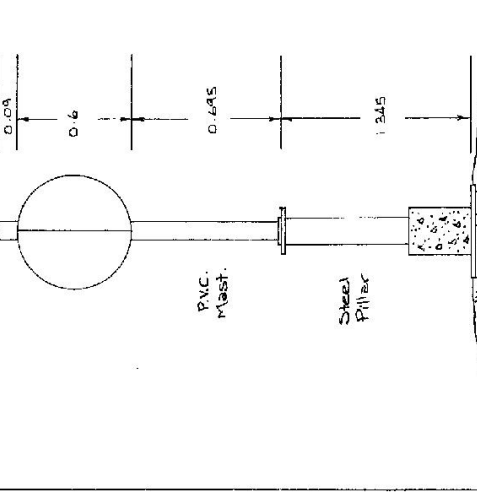

Date: 1977 Record of Station

New Station Mark

STATION T.S.1035 HILLAS (P) IS 10352

Current Occupant.....

Owners Name.. Wallace, Hartsley

Address.....

Address... YAREE


...Gundlakes Road

Access July 1977

Not to Scale

Station Diagram


North

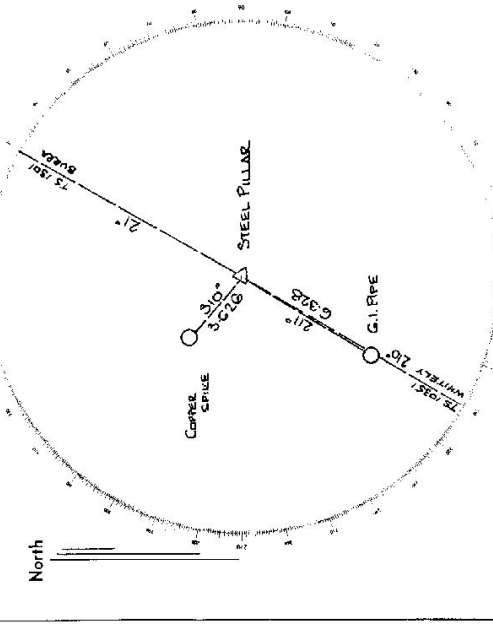

List of Observed Directions:-

Station	Direction	Station	Direction
T.S. 10351 WHITELEY	0° 00' 00"		
G.I. PIPE	0° 51' 40"		
COPPER SPIRE	225° 45' 40"		
T.S. 10301 BOXRA	170° 37' 05"		

Station	Direction	Station	Direction

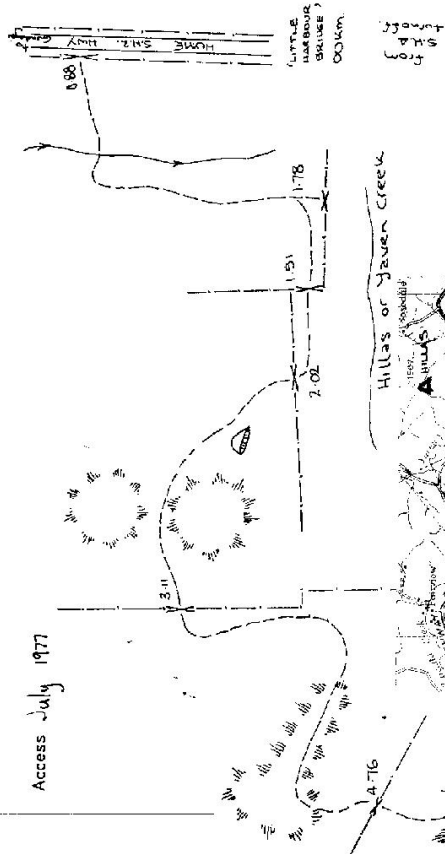

D. West, Government Printer, New South Wales - 1976