

TS-103

Department of Lands  
Integration Survey of N.S.W.  
RECONNAISSANCE and MAINTENANCE REPORT

STATION TS YURANIGH No. 10354  
 Co: ASHBURNHAM Ph: MOLONG  
 Map Sheet: No: \_\_\_\_\_  
 Inspected by: Date: \_\_\_\_\_  
 Authority: Field Book: \_\_\_\_\_

This Trig. Station has been: Note: Cross out word or words which do not apply

1. Completely cleared to permit 360° vision to surrounding Trigs.
2. ~~Cleared by vanes-bearing~~ from Trig-Mast


3. Trig. Mast & Vanes have been painted white & black respectively.
4. The Trig. was unpiled/~~not unpiled~~, dimensions now being:

Description of mark: Steel Pipe Beacon should be explicit, e.g. Steel plug, Brass plug, Bell Concrete Pillar  
 Height of mark: 1.4 m above Roof Level rock/concrete  
 Height of Top Vanes to Top-Mark/Top pillar plate: 1.04 m Diameter of Vanes (vertical) 0.60 m.

Height of Cairn: \_\_\_\_\_ m. Diameter of Cairn: \_\_\_\_\_ m.  
 Length of Mast: \_\_\_\_\_ m. (approximate if not unpiled)  
 5. A Brass set in conc/rock has been placed 1.64 m. bearing 280°M from Trig. Mast/pillar  
 6. A Brass set in conc/soil has been placed 1.60 m. bearing 160°M from Trig. Mast/pillar  
 7. A \_\_\_\_\_ set in conc/soil has been placed 1.60 m. bearing \_\_\_\_\_°M from Trig. Mast/pillar  
 8. A \_\_\_\_\_ set in conc/rock has been placed 1.60 m. bearing \_\_\_\_\_°M from Trig. Mast/pillar

9. Connection: \_\_\_\_\_ to \_\_\_\_\_ m. bearing \_\_\_\_\_°M
10. Connection: \_\_\_\_\_ to \_\_\_\_\_ m. bearing \_\_\_\_\_°M
11. Connection: \_\_\_\_\_ to \_\_\_\_\_ m. bearing \_\_\_\_\_°M
12. Connection: \_\_\_\_\_ to \_\_\_\_\_ m. bearing \_\_\_\_\_°M
13. Diff. Ht. \_\_\_\_\_ is \_\_\_\_\_ m. above/below \_\_\_\_\_
14. Diff. Ht. \_\_\_\_\_ is \_\_\_\_\_ m. above/below \_\_\_\_\_
15. Diff. Ht. \_\_\_\_\_ is \_\_\_\_\_ m. above/below \_\_\_\_\_
16. Diff. Ht. \_\_\_\_\_ is \_\_\_\_\_ m. above/below \_\_\_\_\_

Prepared by: ASSY SURVEYOR BARKY Checked: \_\_\_\_\_

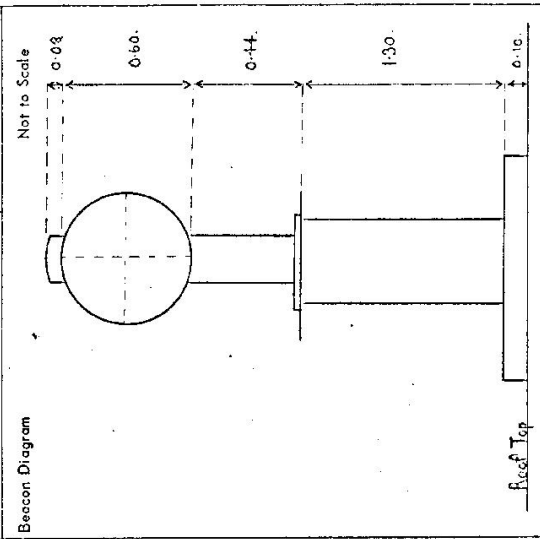

Date: 12/77 Record of Station: Beacon erected



**LAND INFORMATION CENTRE**

GEODETIC SURVEY OF N.S.W.


**GEODETIC STATION RECONNAISSANCE and MAINTENANCE REPORT**

STATION: **YURANIGH** No.: **1035A**

MAP SHEET SCALE 1:250 000 **BATHURST**

INSPECTED BY: **L. HITCHINS** DATE: **29/10/90**

AUTHORITY: **L.I.C.** FIELD BOOK: **---**

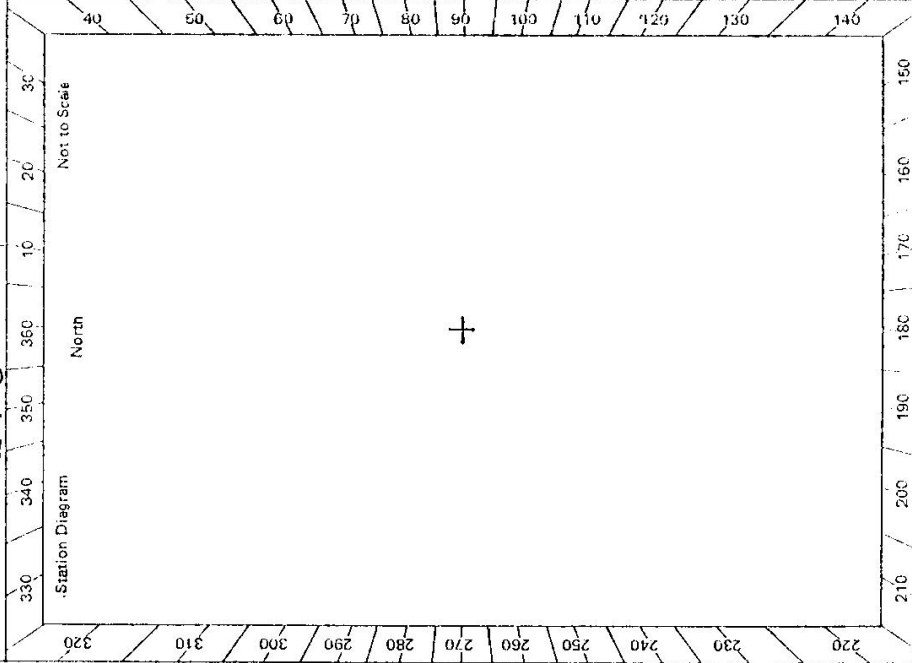


- Description: *Note: Cross out word or words which do not apply*
- Cleared by Janes bearing..... from Trig. Mast
  - Mast & Vanes have been painted white & black respectively. ✓
  - The station/pillar was unpiled/not unpiled/constructed on..... 19....., dimensions now being:
    - Description of mark..... should be explicit, e.g., S/Steel Pillar Plate, Steel plug, Brass plug, Bolt, G.I. Pipe
    - Height of mark.....m. <sup>above</sup> rock/concrete; Mark is.....m. <sup>above</sup> G.L.
    - Height of Top Vanes to Top Mark/Pillar plate.....m. Diameter of Vanes (vertical).....m.
    - Height of Cairn.....m. Diameter of Cairn.....m. Name ~~Plate~~ **found/not found/placed**.
    - Length of Mast.....m. (approximate if not unpiled)
  - A..... set in conc/rock has been placed/found, bearing.....° M from Mast/Plug/Pillar
  - A..... set in conc/rock has been placed/found, bearing.....° M from Mast/Plug/Pillar
  - A..... set in conc/rock has been placed/found, bearing.....° M from Mast/Plug/Pillar
  - A..... set in conc/rock has been placed/found, bearing.....° M from Mast/Plug/Pillar
  - Action required:.....

STANDPOINT:				STANDPOINT:			
Mark	Direction	Horiz. Distance	Height Difference	Mark	Direction	Horiz. Distance	Height Difference
			above standpt. below				above standpt. below
			above standpt. below				above standpt. below
Prepared by: *[Signature]* Checked: *[Signature]* Noted on U.T.M. Card

S: 2733-2 D. West. Government Printer

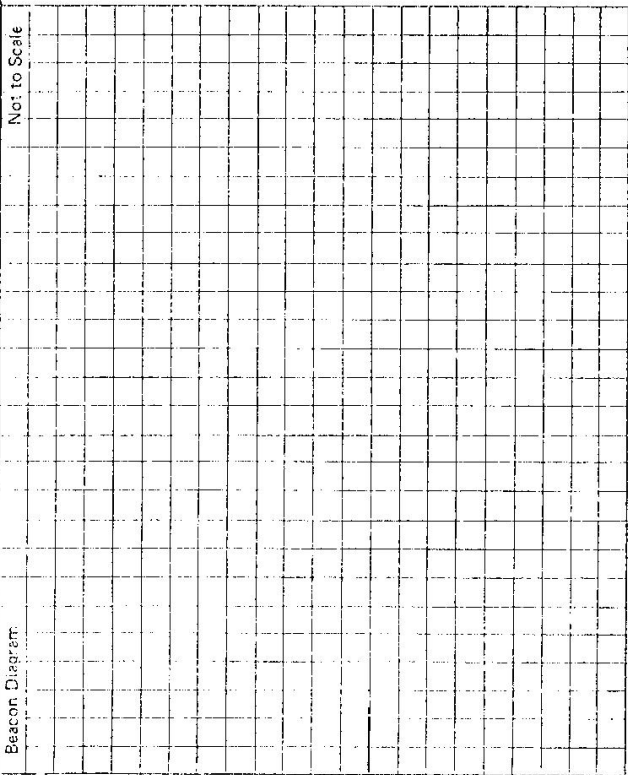STATION <b>YURANICH TS 10354</b>	Owner's Name: <b>CABONNE SHIRE</b> Address: <b>Molong Dist</b> Office Phone: <b>668303 - 063</b>	Current Occupant: ..... Address: ..... Phone: .....	ACCESS Access Report of <b>21.10.90</b> was found suitable/unsuitable.  <b>D.O. MOLONG PO HEAD WEST ALONG BANK STREET</b> <b>0.18 PLU KEY FROM SHIRE ON R.H.S STRAIGHT AHEAD</b> <b>0.27 TURN LEFT INTO EDWARD STREET</b> <b>1.24 TURN LEFT INTO DARK STREET</b> <b>1.39 WATER TREATMENT WORKS ON R.H.S</b> (INTO BUILDING + UP STEPS TO TRIC)
Beacon Diagram: <span style="float: right;">Not to Scale</span> 		Note: Yuranich T.S. is on the roof of a building at the water treatment works. An access key must be obtained from the Cabonne Shire Office	
This section to be completed by officer constructing pillar. Original station mark found/not found.		Date Record of Station	
Description of mark: ..... Original beacon found/not found.		Height: Top of Vanes to Top Mark .....m. Height of mark .....m. above G.L. below Diameter of Vanes .....m. Height of Cairn .....m.	
Description of beacon: ..... Height: Top of Vanes to Top Mark .....m. Height of mark .....m. above G.L. below Diameter of Vanes .....m. Height of Cairn .....m.		Original Beacon has/has not been destroyed by me.	