

7/10/1

Department of Land's  
 This Trig. Station has been:-

Integr. Survey of N.S.W.  
 RECONNAISSANCE and MAINTENANCE REPORT

STATION **T.S. POLWARA PILLAR 10356**  
 Co: **Northumberland** Ph: **Middleknap**  
 Map Sheet: **Meadville** No: **5480**  
 Inspected by: **P. MCHUGH** Date: **23.5.17**  
 Authority: **I.S.D. N.Z.L.E.** Field Book: **PDP 844**  
 Beacon Diagram Not to Scale

Note: Cross out word or words which do not apply

1. Completely cleared to permit 360° vision to surrounding Trigs. ✓
2. Cleared by ~~lines-bearing~~ **from Trig Mast**
3. Trig. Mast & Vanes have been painted white & black respectively. ✓
4. The Trig. was unpiled/~~not unpiled~~, dimensions now being:

Description of mark **steel roof-top beacon** should be explicit, e.g. Steel plug, Brass plug, Botl, Concrete Pillar


Height of mark ~~.....~~ **4.53** m above ~~.....~~ **G.L.**  
 Height of Top Vanes to ~~Top Mast~~ **rock concrete** Top pillar plate **1.33** m Diameter of Vanes (vertical) **0.60** m.

Height of Centre ~~.....~~ Diameter of Centre ~~.....~~  
 Length of Mast **1.42** m. (approximate if not unpiled)

5. A..... set in conc/rock has been placed/fd ..... m. bearing .....°M from Trig. Mast/pillar
6. A..... set in conc/soil has been placed/fd ..... m. bearing .....°M from Trig. Mast/pillar
7. A..... set in conc/soil has been placed/fd ..... m. bearing .....°M from Trig. Mast/pillar
8. A..... set in conc/rock has been placed/fd ..... m. bearing .....°M from Trig. Mast/pillar

9. Connection..... to..... m. bearing .....°M
10. Connection..... to..... m. bearing .....°M
11. Connection..... to..... m. bearing .....°M
12. Connection..... to..... m. bearing .....°M
13. Diff. Ht. .... is..... m. above/below
14. Diff. Ht. .... is..... m. above/below
15. Diff. Ht. .... is..... m. above/below
16. Diff. Ht. .... is..... m. above/below

Prepared by: **CSA** Checked: **PAW 24.6.17**

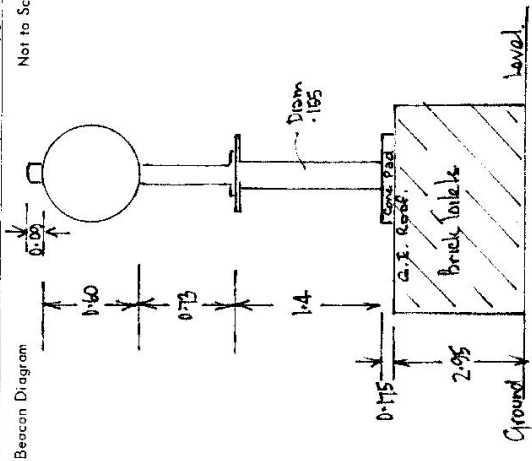

Date **21/5/17** Record of Station **Steel Roof-top Beacon erected on Table Top.**

STATION TS. BOLL CA PILLAR 10356

Owners Name: Maitland City Council Current Occupant: Maitland City Council

Address: Council Chambers Address: Maitland

Access: 23-5-1977

Km: Fezale

0.0: New England Highway at Maitland P.O.

0.65: Travel towards Singleton on New England Hwy.

0.85: Turn right at traffic signals - sign "Bolwarra"


3.3: Cross "Bolwarra Bridge" - follow main road towards Bolwarra.

5.25: Turn right past school.

Turn right into Lookout picnic area.

Trig is on bridge Toilet Block.

Access by bitumen roads.

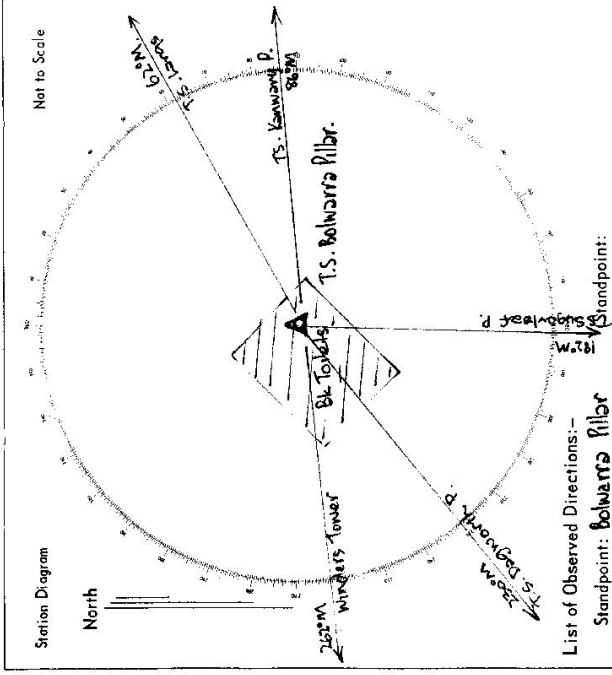

List of Observed Directions:-  
Standpoint: Bolwarra Pillar

Station	Direction	Station	Direction
TS. Lamps	0° 00' 00"		
TS. Kenway P.	24° 14' 32.75"		
TS. Sugarloaf P.	155° 23' 36.58"		
TS. Deewort P.	199° 36' 01.50"		
Winders Tower	202° 55' 02.00"		
Station	Direction	Station	Direction

CENTRAL MAPPING AUTHORITY  
 GEOBETIC SURVEY OF M.S.W  
 GEOBETIC STATION RECONNAISSANCE and MAINTENANCE REPORT

STATION: **BOLNARRA TS.** No.: **10356**

MAP SHEET  
 SCALE 1:250 000

INSPECTED BY: **P OKANE** DATE: **9/07/1990**

AUTHORITY: **LANDS DEPT** FIELD BOOK: **477/3**

Description: *Note: Cross out word or words which do not apply*

1. Cleared by lanes bearing..... from Trig. Mast
2. Mast & Vanes have been painted white & black respectively.
3. The station/pillar was unpiled/not unpiled/constructed on.....19....., dimensions now being:  
 Description of mark.....should be explicit, e.g., S/Steel Pillar Plate, Steel plug, Brass plug, Bolt, G.I. Pipe  
 Height of mark.....m. <sup>above</sup> rock/concrete; Mark is.....m. <sup>above</sup> G.L.
- Height of Top Vanes to Top Mark/Pillar plate.....m. Diameter of Vanes (vertical).....m.
- Height of Cairn.....m. Diameter of Cairn.....m. Name Plate found/not found/placed.
- Length of Mast.....m. (approximate if not unpiled)
4. A.....set in conc/rock has been placed/found, bearing.....° M from Mast/Plug/Pillar
5. A.....set in conc/rock has been placed/found, bearing.....° M from Mast/Plug/Pillar
6. A.....set in conc/rock has been placed/found, bearing.....° M from Mast/Plug/Pillar
7. A.....set in conc/rock has been placed/found, bearing.....° M from Mast/Plug/Pillar
8. Action required.....  
 NEW MAST \$ VANE HEIGHT

STANDPOINT:


Mark	Direction	Horiz. Distance	Height Difference	Mark	Direction	Horiz. Distance	Height Difference
			above standpt				above standpt
			below				below
			above standpt				above standpt
			below				below
Prepared by: *[Signature]*

Checked: *[Signature]*

ST 2733-1


Noted on U.T.M. Card

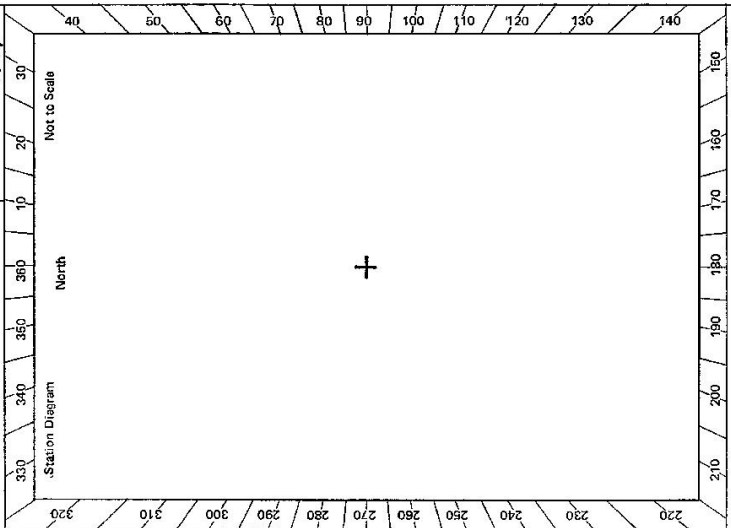

STATION **Box WARE T.S. 10356**

Owner's Name: .....  
 Address: .....  
 Phone: .....  
 Current Occupant: .....  
 Address: .....  
 Phone: .....

9-5-1990  
 Access Report of Access was found suitable/unavailable

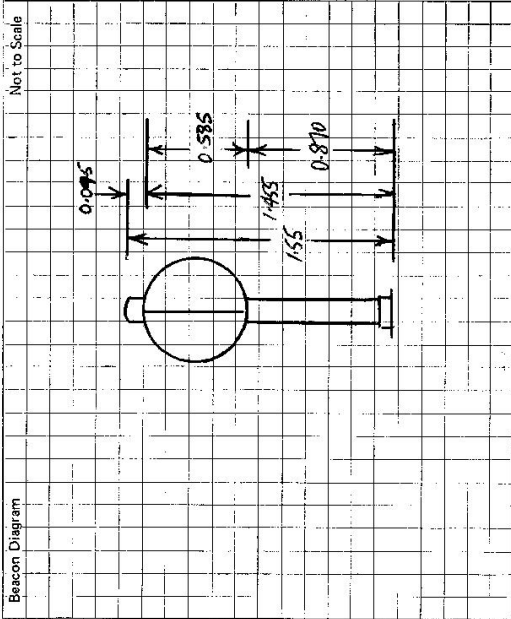

This section to be completed by officer constructing pillar.

Original station mark found/not found. Roof top Pillar with Pillar Post

Description of mark: Plastic Mast with Metal Vanes

Original beacon found/~~not found~~ & Replaced

Description of beacon: Plastic Mast with Metal Vanes

Height Top of Vanes to Top Mark: 1.455 m.

Height of mark:  above G.L.  below

Diameter of Vanes 0.585 m.

Height of Cairn  m.

Original Beacon has/has not been destroyed by ma.

Date 9/07/90 Record of Station New Mast & Vanes to Replace old one replaced at Flag