


STATION IS 10365 HANKE SOLBY LO (P)


Owners Name: Current Occupant:

Address: Address:

Access 18-7-1977 CAR PARK and BARBQ AREA

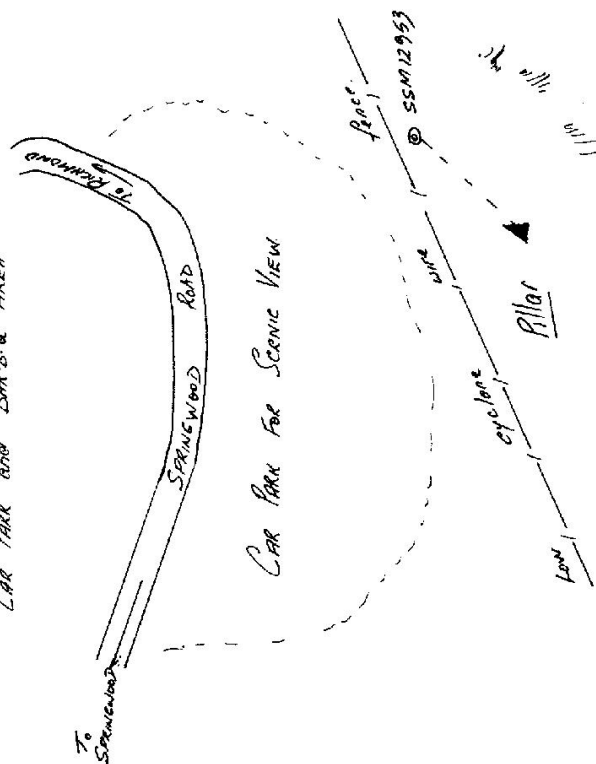

D. West, Government Printer, New South Wales - 1976

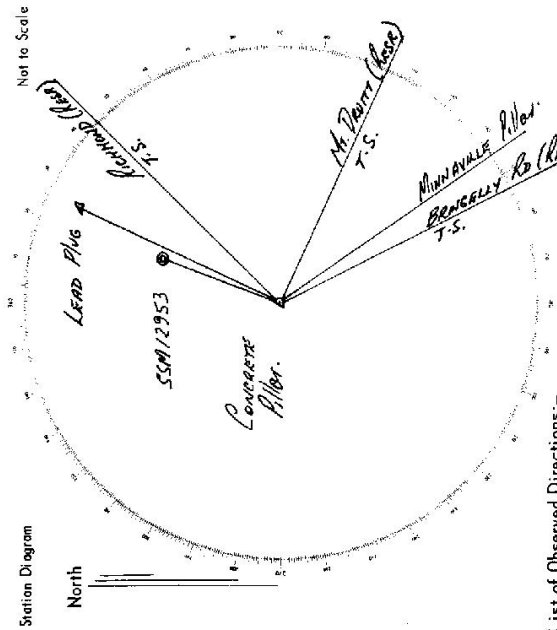

List of Observed Directions:-

Standpoint: Concrete Pillar		Standpoint:	
Station	Direction	Station	Direction
Richmond (Road) T.S.	0 00 00		
Mt Dorr (Road) T.S.	66 50 57		
Mountain Pillar	97 47 18		
Benicully Rd (Road) T.S.	105 36 51		
Station	Direction	Station	Direction
SSM12953	339 11 02		
Lead Pile	359 06 06		