


STATION TS 10371 PORTAL [P]

Owners Name: **BLOOM MOUNTAINS NATIONAL PARK** Current Occupant:

Address:

31-8-1977
 Access **CLENBROOK RLY STN.** 0 KM
FOLLOW BRIDGE RD 1.1
RUN OVERHEAD BRIDGE 1.3
PARK GATE 2.7
CAUSEWAY 4.5
TURN LEFT 5.2
START OF RISE 6.1
TURN RIGHT 6.5
THE PORTAL LOOKOUT 8.1 KM

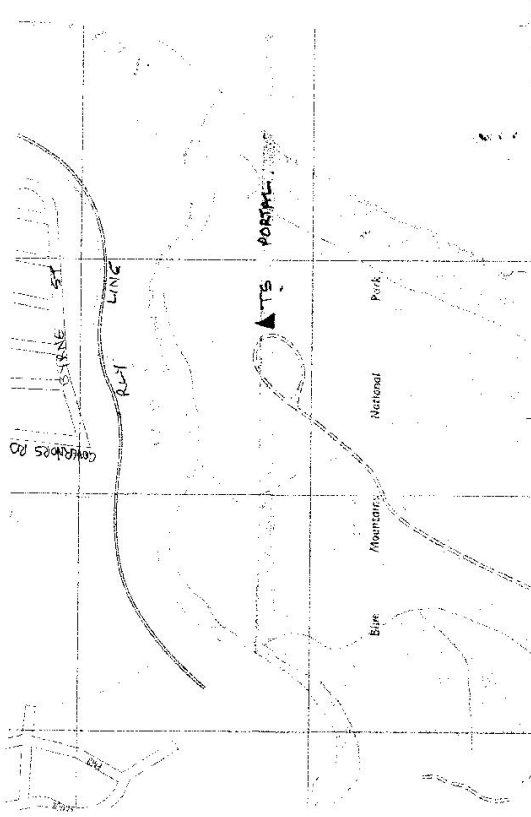

Station Diagram

Not to Scale

1.825
 3.215
 5.578
 50.938
 0.874
 9.474
 36.214

Drill hole
 Lookout (P)
 Quarry (P)
 Orcharahills
 Brinkley Rd
 Lead plug in rock
 Lead plug in rock

See FB 617 Pages 3, 5, 7

List of Observed Directions:-

Station	Direction	Station	Direction
Lookout (P)	179° 07' 10"	Drill hole	179° 07' 10"
Quarry (P)	185° 43' 07"	SSM 12954 DH 2	185° 43' 07"
Orcharahills	257° 11' 18"	Drill hole	257° 11' 18"
Drill hole	357° 38' 22"	Drill hole	357° 38' 22"
Brinkley Rd	180° 45' 00"	SSM 12954 DH 2	180° 45' 00"
SSM 12954 DH 2	359° 58' 37"	Lookout (P)	359° 58' 37"
Portal (P)	43° 00' 00"	SSM 12954 CS 1	43° 00' 00"
Lookout (P)	169° 01' 43"	SSM 12954 CS 2	169° 01' 43"
SSM 12954	44° 00' 00"	SSM 12954 DH 2	44° 00' 00"
	271° 33' 52"		271° 33' 52"
	348° 52' 45"		348° 52' 45"
	350° 14' 35"		350° 14' 35"

Standpoint: **RUAR CONT'D**

Standpoint: **SSM 12954**

Standpoint: **SSM 12954 DH 2**