

STATION T.S (SKEIN) 10374

Owners Name..... Current Occupant.....

Address..... Address.....


9th - 6-1977

ACCESS IS BY ROAD FROM TOWN OF SANDAY IN WETLANDS AND WEATHER. HOWEVER ROAD IS VERY SLIPPERY WHEN WET

AT SANDAY POST OFFICE 0.6 KMS INTO BURNING ST THEN RIGHT INTO ROVER ST PROCEED ALONG ROVER ST PAST SANDAY STATION AND SANDAY ST AT T-INTERSECTION 0.9 KM CROSS SANDAY LAKE AND FOLLOW SANDAY ROAD (MILL ST) 2.2 KM CROSS BRIDGE AT CLUNCE AND TAKE RIGHT 2.3 KM TO FOLLOW SIGN TO LAKE BURNING 3.5 KM TAKE RIGHT TURN OFF SANDAY ROAD AT SIGN TO LAKE BURNING

4.7 KM T.S SKEIN IN PARADEL ON LEFT

Station Diagram

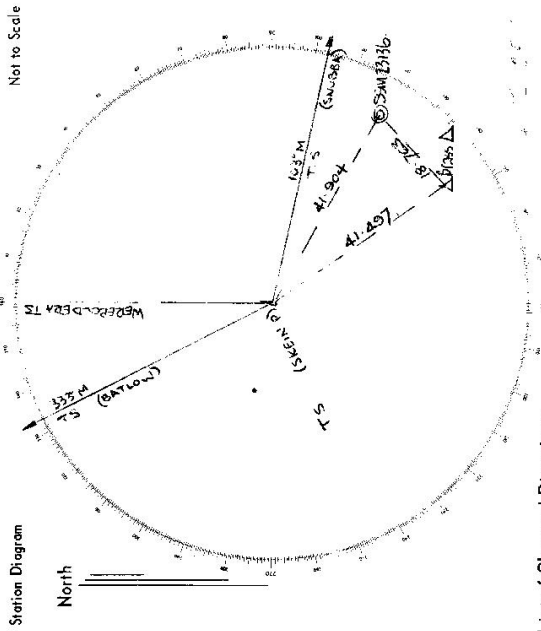

List of Observed Directions:-

Standpoint: Pile
Standpoint: SKEIN 23136

Station	Direction	Station	Direction
SANDAY T.S.	370 05 03	WATERBURY T.S.	353 59 60
WATERBURY T.S.	C 23 54	SANDAY T.S.	222 55 28
SANDAY T.S.	172 50 06	SANDAY 23136	278 47 28
SANDAY 23136	119 05 35		
SANDAY 41497	145 05 09		