
	I NULLON OF						4			12		
		GEC	DETIC STATION	GEODETIC STATION RECONNAISSANCE and MAINTENANCE REPORT	IND MAINTEN	ANCE REF	ORT	STATION: BO	BOLLARD	٥	No.:	№.: 1039
Description:		•	12	Note: Cross out word or words which do not apply	vords which do	i not apply		MAP SHEET SCALE 1:250 000	CANBERRA	ERRA		
1. Cleared by lanes bearing	oearing	13 40	55	from Trig. Mast	from Tri	ig. Mast		INSPECTED BY: WILLER	W. MILLE	R	DATE: 542.18	18
2. Mast & Vanes hav	re been paint.	ed white {	Mast & Vanes have been painted white & black respectively.	2				AUTHORITY:	CMA		FIELD BOOK:	
<ol> <li>The station/pillar-</li> </ol>	was unpiled/	not unpil	ed/c <del>enstructe</del> d on	The station/ <del>piller was unpile</del> d/not unpiled/c <del>onstructed</del> on	3., dimensions !	now being:		330 340	350	360	1 20 1	30
Description of ma	rk	outs	uld be explicit, e.g.,	Description of markshould be explicit, e.g., S/Steel Pillar Plate, Steel plug, Brass plug, Bolt, G.I, Pipe	sel plug, Brass p	plug, Bolt,	G.I, <b>P</b> ipe	Station Diagram		North	Not to Scala	cala
Height of markm. <sup>aboue</sup> rock/concrete;	ц.	<sup>above</sup> rock	/concrete;	Mark ism. <sup>above</sup> G.L.	bove G.L.							
Height of Top Vanes to Top Mark/Pillar	nes to Top N	lark/Pillar	platem.		Diameter of Vanes (vertical)m.	tical)	Ľ.	0				
Height of Caim	<b>1</b> t	Sn.	Diameter of Ca	Diameter of Cairn	Name Plate found/not found/placed.	inot four	id/placed.	16				
Length of Mast	4	E S	(approximate if not unpiled)	t unpiled)				005				
A	set i	n conc/ro	ck has been placed/	4. A	°M from Mast	t/Plug/Pilla	~	/0				
5. A.	set ii	n conc/ro	ck has been placed/	A	°M from Mast	t/Plug/Pilla		62 /				
6. A	ii təs	n conc/roi	ck has been placed/	A	<sup>5</sup> M from Mast	t/Plug/Pílla		08Z				
А	set in	n conc/roi	ck has been placed/	7. A	°M from Mast	t/Plug/Pilla		0/2		+		
Action required:				8. Action required:				560				
STANDPOINT:				STANDPOINT:				0				
Mark	Direction	Horiz. Distance	Height Difference	Mark	Direction	Horiz. Distance	Height Difference	se /				
			above standpt. below				above below standpt.	540				
			above standpt. below				above below standpt.					
			above standpt.				above below standpt.	530				
			above standpt. below				above standpt.					
			above standpt. below			-	above standpt.					
			above standpt. below				above standpt.	525				
8	200 200		above standpt. below				above standpt. below	210 / 200	/ 190	180	170 160	150
Democrat bur 1.40 And D	W AN D	- 100			Ale	Matod on U T M Card	A Card		Charlend	1		

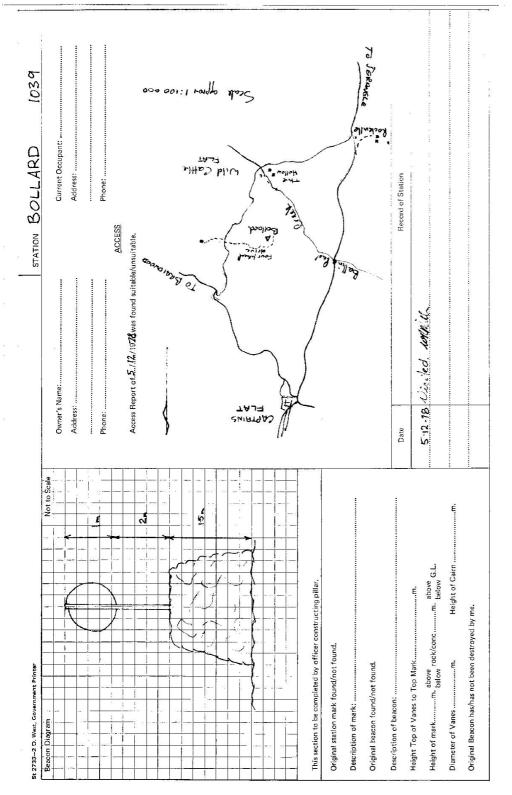

-