

STATION TS 10394 HORNSEY [P]

Owners Name: J. L. SIMP
 CHIEF EXECUTIVE OFFICER
 for

FRANK WHIDDON MASONIC
 HOMES OF N.S.W

Address: 81 BELMONT ROAD
 GLENFIELD 2161

Phone: 605 5111

Current Occupant:


Address:

Access



NOTE: BEACON IS CURVED TO TOP OF PILLAR PLATE
 SPANNER (AS WELL AS ALUM KEY) IS REQUIRED TO REMOVE BEACON

D. West, Government Printer, New South Wales - 1976

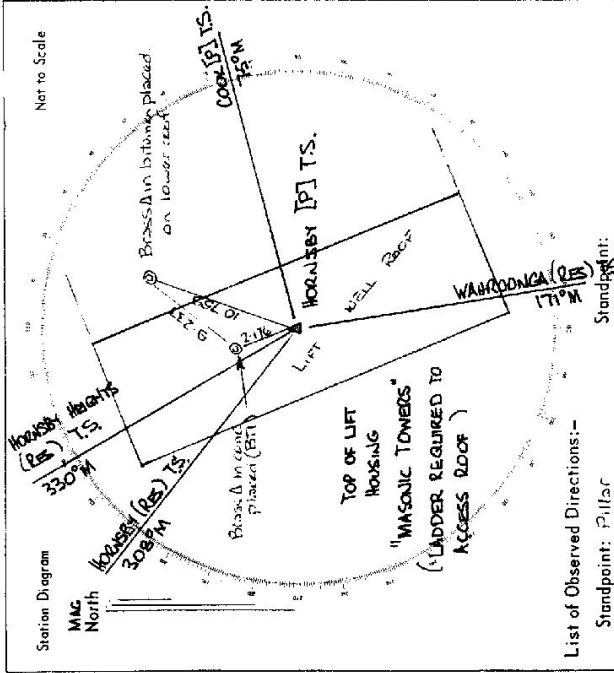


List of Observed Directions:-

Station	Direction	Station	Direction
WARRONGA TS	171° 00'		
HORNSEY RES TS	153° 43' 22"		
HORNSEY HEIGHTS TS	158° 45' 52"		
BT1	167° 06' 23"		
BT2	268° 21' 07"		
BT2			
HORNSEY HEIGHTS TS	272° 04' 00"		
PILLAR	273° 42' 40"		
BT1	285° 33' 23"		

STATION Hornsby TS 10394

Owners Name...THE FRANK WHIDDON MASONIC HOMES OF N.S.W.
 Current Occupant.....
 Address...REGISTERED OFFICE: 81 BELMONT ROAD, GLENFIELD. 2167.
 Address.....
 Access...(MR. J.H. SHARP. 14-10-80) CHIEF EXECUTIVE OFFICER) HORNSBY HOSPITAL GROUNDS. LOWE ROAD, HORNSBY.
GO TO 10TH FLOOR OF THE MASONIC TOWERS BUILDING. OBTAIN KEY TO ROOF FROM MATRON / SISTER ON DUTY.
PILLAR IS LOCATED ON TOP OF 5m HIGH LIFT WELL. A LADDER IS REQUIRED.

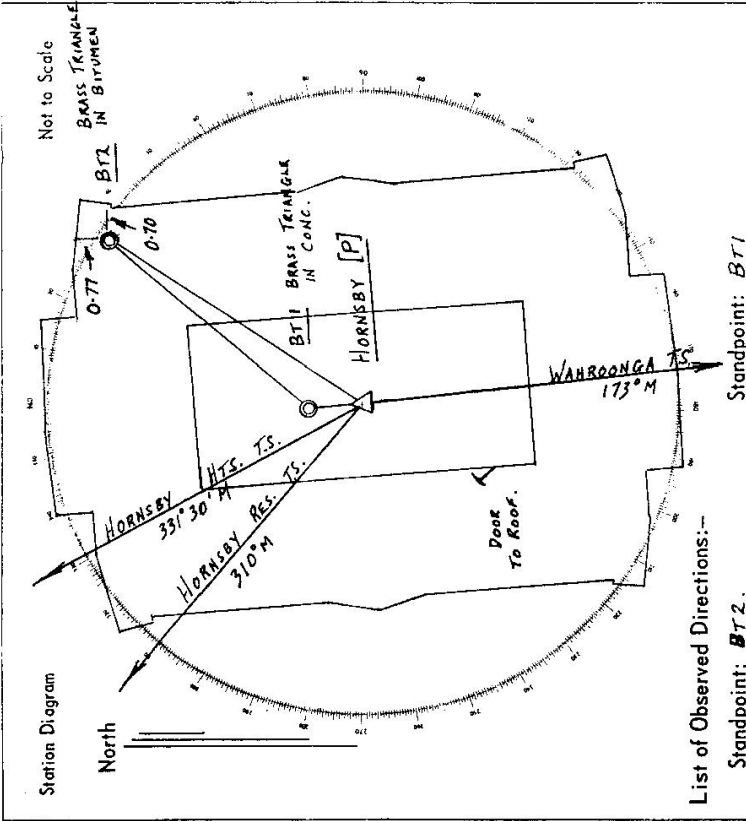

List of Observed Directions:-

Standpoint: BT2.		Standpoint: BT1	
Station	Direction	Station	Direction
HORNSBY HEIGHTS T.S.	0° 00' 00"	HORNSBY HEIGHTS T.S.	0° 00' 00"
HORNSBY [P]	229° 42' 39"	WAHROONGA T.S. (AERIAL)	201° 15' 28"
BT1	238° 38' 25"	BT2	58° 32' 30"
HORNSBY RES. T.S.	334° 50' 56"	HORNSBY RES. T.S.	335° 03' 33"
STANDPOINT: PILLAR			
Station	Direction	Station	Direction
WAHROONGA T.S. (AERIAL)	0° 00' 00"		
HORNSBY RES. T.S.	133° 49' 22"		
BT1	167° 06' 23"		
BT2	208° 21' 07"		