


STATION TS 10422 GLENFIELD PARK

Owners Name: Dept. of Education
Current Occupant: Glenfield Park School


Address:

Station Diagram
North
Not to Scale

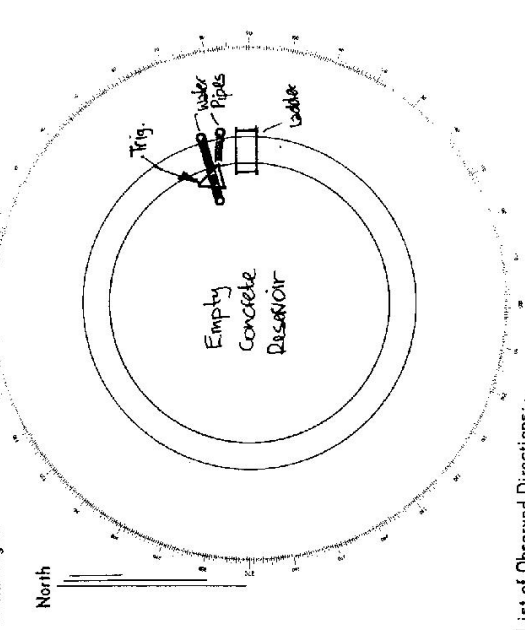

List of Observed Directions:-

Standpoint:		Standpoint:	
Station	Direction	Station	Direction

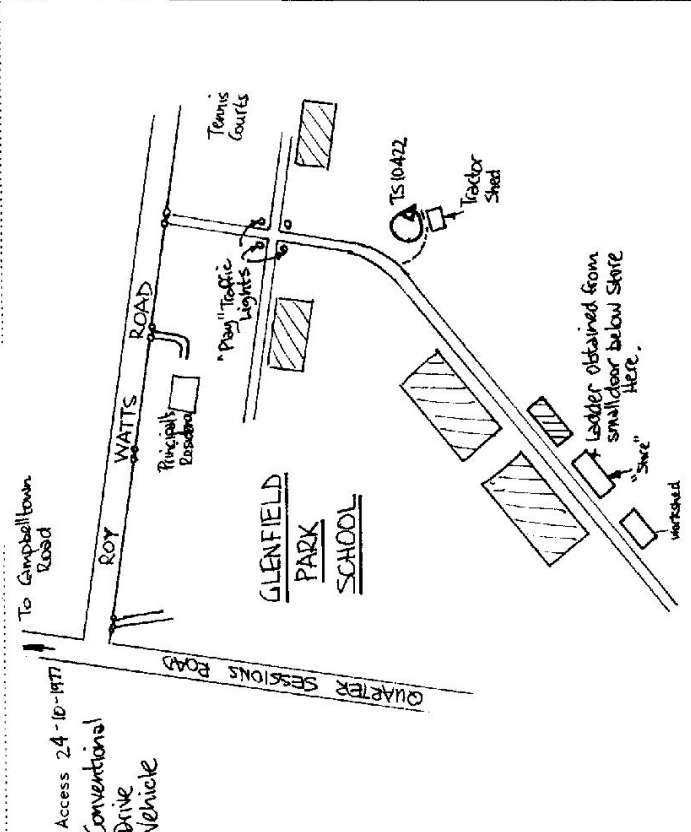

D. West, Government Printer, New South Wales - 1976