








STATION TS 10431 KIA ORA (P)

Owners Name.....  
 Current Occupant.....  
 Address.....  
 Address.....

9-11-78  
 Access via  
 0-0 Gloucester RD - take Seeme Metcha Rd.  
 A-2 Turn right - sign "Kia Ora Lookout"  
 S-65 " " " " " "  
 6-95 Turn left " " " " " "  
 7-7 TRIG.

2 wheel drive in all conditions.

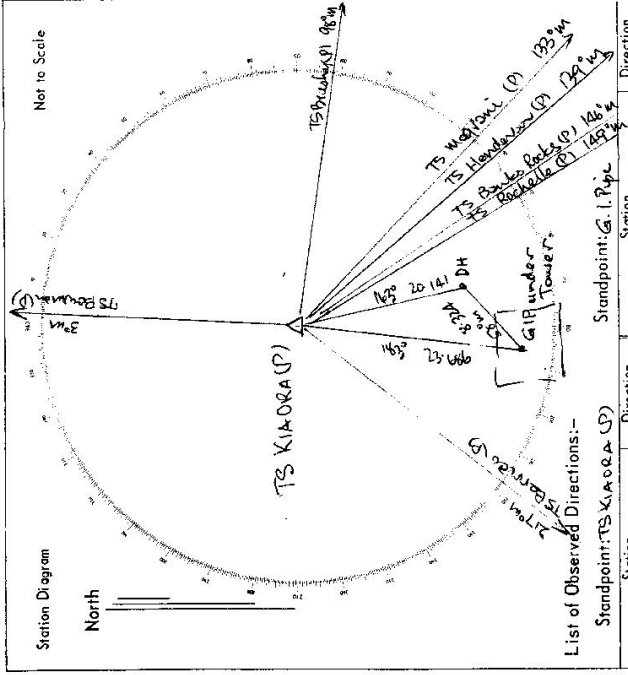

List of Observed Directions:-

Station	Direction	Station	Direction
TS Boko Rocks (P)	0° 00' 00"	TS Boko Rocks (P)	0° 00' 00"
TS Rochella (P)	3° 26' 21.17"	TS Kia Ora (P)	210° 42' 56.5"
D.H.	15° 48' 31"	D.H.	271° 59' 11"
G.I. Pipe	36° 39' 36.5"		
TS Berried (P)	65° 00' 29.78"		
TS Bannin (P)	211° 16' 45.29"		
TS Brushy (P)	213° 03' 53.42"		
TS Magyoni (P)	240° 54' 08.17"		
TS Mendenham (P)	247° 30' 20.38"		