

STATION **BLACK** **BERKYS (P)TS10439**


Current Occupant.....

Address.....

Owners Name.....

Address.....

Access 6-11-1979

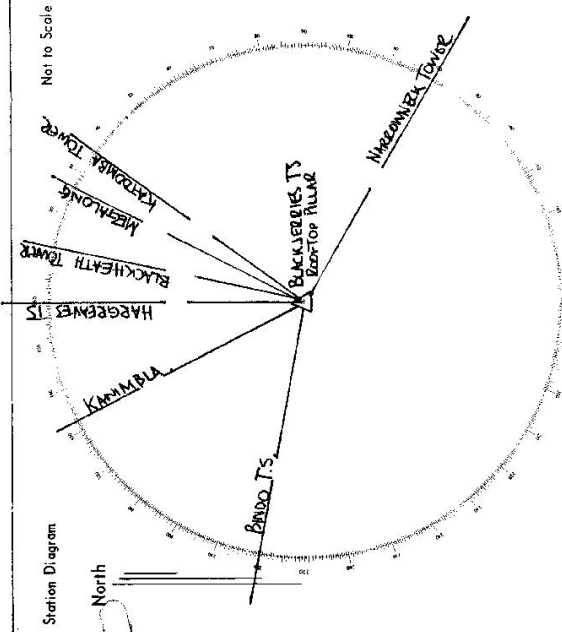


List of Observed Directions:-

Standpoint:		Standpoint:	
Station	Direction	Station	Direction

Department of Lands
 Integrate Survey of N.S.W.
 RECONNAISSANCE and MAINTENANCE REPORT

STATION TS 10439 BLACK JERRYS (P)
 Co: COOK Ph: MEGALONG
 Map Sheet: JENOLAN No: B930-III-N
 Inspected by: L.M HAYES Date: 6/11/19
 Authority: INHERITANCE SURVEYS Field Book: 1372/2

Beacon Diagram
 Not to Scale

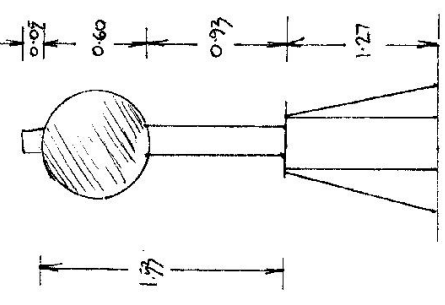

This Trig. Station has been:-
 Note: Cross out word or words which do not apply

1. Completely cleared to permit 360° vision to surrounding Trigs.
2. Cleared by lines bearing _____ from Trig. Mast
3. Trig. Mast & Vanes have been painted white & black respectively.
4. The Trig. was unpiled/~~not unpiled~~, dimensions now being:
 Description of mark: Loophole Pillar
 Height of mark: 1.27 m ^{above}/_{below} rock concrete 1.27 m ^{above}/_{below} G.L.

Height of Top Vanes to ~~Top Mast~~ Top pillar plate 1.53 m Diameter of Vanes (vertical) 0.60 m.
 Height of Cairn _____ m. Diameter of Cairn _____ m.
 Length of Mast _____ m. (approximate if not unpiled)

5. A. _____ set in conc/rock has been placed/fd _____ m. bearing _____ °M from Trig. Mast/pillar
6. A. _____ set in conc/soil has been placed/fd _____ m. bearing _____ °M from Trig. Mast/pillar
7. A. _____ set in conc/soil has been placed/fd _____ m. bearing _____ °M from Trig. Mast/pillar
8. A. _____ set in conc/rock has been placed/fd _____ m. bearing _____ °M from Trig. Mast/pillar
9. Connection _____ to _____ m. bearing _____ °M
10. Connection _____ to _____ m. bearing _____ °M
11. Connection _____ to _____ m. bearing _____ °M
12. Connection _____ to _____ m. bearing _____ °M
13. Diff. Ht. _____ is _____ m. ^{above}/_{below}
14. Diff. Ht. _____ is _____ m. ^{above}/_{below}
15. Diff. Ht. _____ is _____ m. ^{above}/_{below}
16. Diff. Ht. _____ is _____ m. ^{above}/_{below}

Prepared by: L.M HAYES Checked: [Signature]
 Date _____ Record of Station _____

STATION TS 10429 | BLACK JERRYS (P)

Current Occupant.....

Address.....


Owners Name.....

Address.....


CONVENTIONAL VEHICLE

Access

- 0.00KM BLACKHEATH (LEVEL CROSSING) OVER CROSSING FROM HWY TURN LEFT SHIPLEYS ROAD.
- 0.45 KM YEBER RIGHT (SHIPLEYS ROAD)
- 1.25 KM THEN LEFT MEGALONG VALLEY TURN OFF STOPPED
- 13.70 KM MEGALONG PUBLIC SCHOOL ON LEFT.
- 15.45 KM OVER CONC CULVERTWAY.
- 19.15 KM TURN RIGHT (GATE) "BALLYMORE"
- 19.35 KM STRAIGHT AHEAD (BALLYMORE HOUSE ON LEFT)
- 19.75 KM GATE LITTLE RIVER COUNTER WARE STOP, THROUGH HOUSE ON RIGHT CONTRA OWNER & LET HIM KNOW BEFORE PROCEEDING TO TS, AS PER DIAGRAM

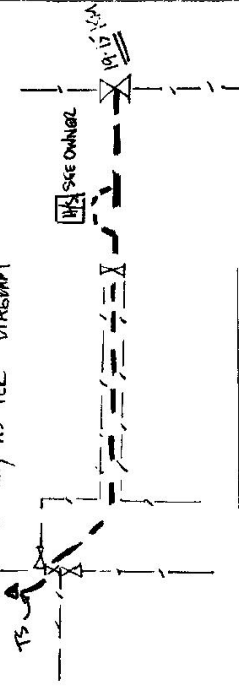

D. West, Government Printer, New South Wales - 1976

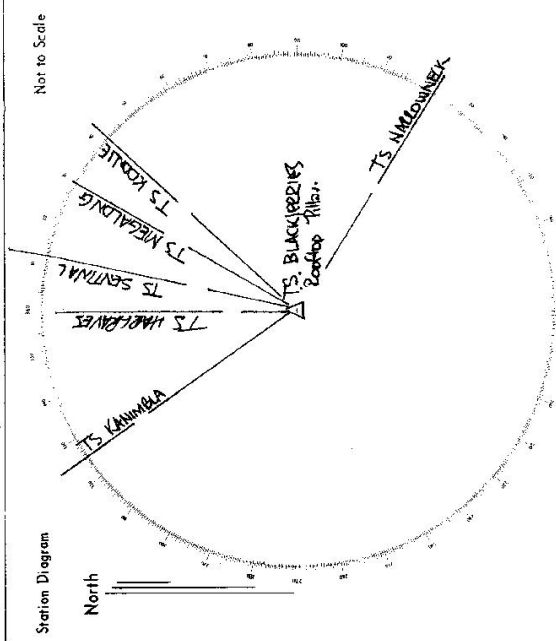

List of Observed Directions:-

Station	Direction	Station	Direction
TS KANIMBLA	0° 00' 00"		
TS SENTINAL	11° 27' 01.5"		
TS MEGALONG	27° 05' 31.7"		
TS KOONJE	41° 57' 37.7"		
TS MARLBOROUGH	121° 19' 24.6"		
TS KANIMBLA	329° 32' 17.6"		