


75 103

STATION T.S. BREADALBANE HILL [P] 10444  
 Co: ARGYLE  
 Map Sheet: GOULBURN 1: 25,000  
 Inspected by: S. Greening  
 Authority: D. M. R.  
 No: 8828-III-N  
 Date: Sep. '79  
 Field Book:

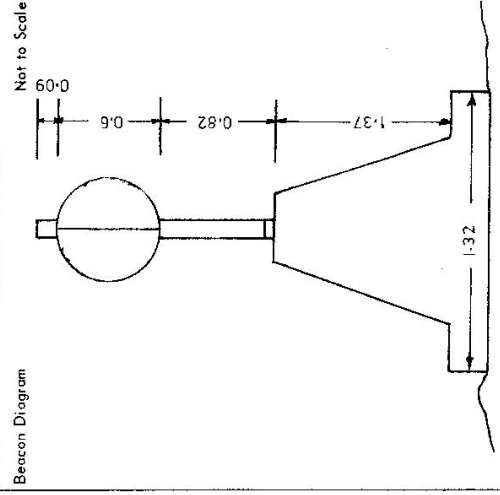

Date	Record of Station
29/8/79	Pillar erected by J.S.B.

Department of Lands  
 Integrating survey of N.S.W.  
 RECONNAISSANCE and MAINTENANCE REPORT

This Trig. Station has been:-  
 Note: Cross out word or words which do not apply

1. Completely cleared to permit 360° vision to surrounding Trigs. ✓
2. ~~Cleared by James bearing~~ from Trig-Mast
3. Trig. Mast & Vanes have been painted white & black respectively. **NEW PILLAR built 29/8/79**
4. ~~The Trig. was unplaced/not unplaced, dimensions new being:~~

Description of mark: **CONCRETE PILLAR** should be explicit, e.g. Steel plug, Brass plug, Bolt, Concrete Pillar  
 Height of mark: 1.37 m <sup>above</sup>/<sub>below</sub> rock/concrete ..... m above/below G.L.  
 Height of Top Vanes to Top Mark/Top pillar plate: 1.42 m Diameter of Vanes (vertical) 0.6 m.  
 Height of Cairn: ..... m Diameter of Cairn: ..... m.

- Length of Mast: ..... m (approximate if not unplaced)
5. A Copper Spike set in ~~some rock~~ <sup>conc.</sup> placed ~~has been placed at~~ 7.254 m, bearing 177° M from Trig. Mast/pillar
  6. A SSM 36242 set in conc/soil has been placed at 5.082 m, bearing 085° M from Trig. Mast/pillar
  7. A ..... set in conc/soil has been placed at ..... m, bearing .....° M from Trig. Mast/pillar
  8. A ..... set in conc/rock has been placed at ..... m, bearing .....° M from Trig. Mast/pillar
  9. Connection SSM to Cu. spike: 0.440 m, bearing 222° M
  10. Connection to ..... m, bearing .....° M
  11. Connection to ..... m, bearing .....° M
  12. Connection to ..... m, bearing .....° M
  13. Diff. Ht. Copper spike is 1.54 m. <sup>above</sup>/<sub>below</sub> Pillar
  14. Diff. Ht. SSM 36242 is 1.56 m. <sup>above</sup>/<sub>below</sub> Pillar
  15. Diff. Ht. is ..... m. <sup>above</sup>/<sub>below</sub>
  16. Diff. Ht. is ..... m. <sup>above</sup>/<sub>below</sub>

Prepared by: P. CURTIS Checked: Agreements (D.M.R.)


STATION T.S. B ADALBANE HILL [P]

TS 10444

Owners Name: Bert FRIEND  
 Current Occupant: Not Occupied


Address: "Thornleigh" Station  
 Address

PARKESBOURNE  
 Phone: Goulburn 292 117  
 Access Sept 1979

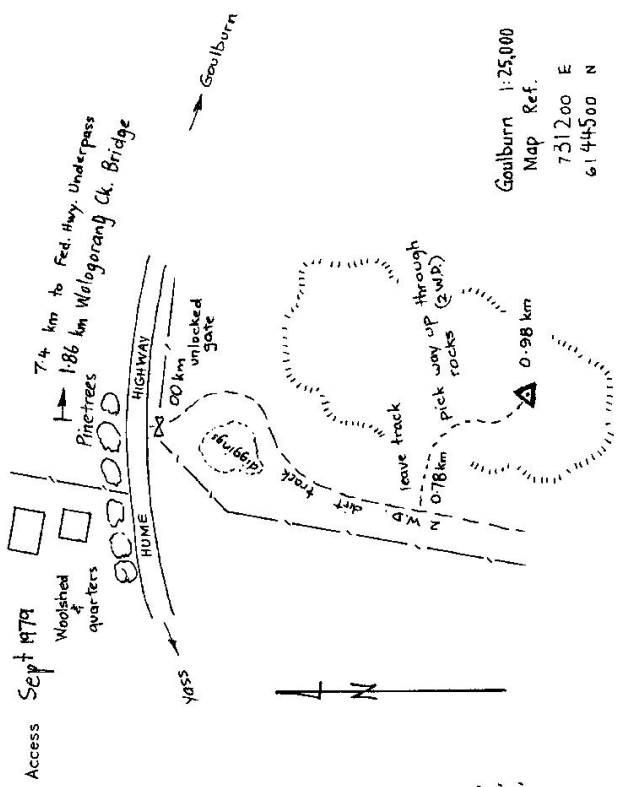

Goulburn 1:25,000  
 Map Ref.  
 731200 E  
 6144500 N

D. West, Government Printer, New South Wales - 1976

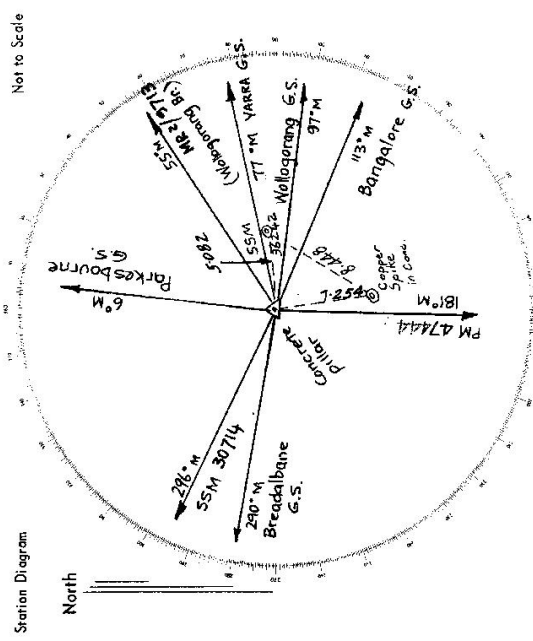

Station Diagram

Not to Scale

Standpoint: PILLAR  
 Standpoint: SSM 36242

Station	Direction	Station	Direction
G.S. Breadalbane [P]	0° 00'	Parkesbourne [P]	0° 00' 00"
Parkesbourne [P]	77° 53' 12"	Wollogorang [P]	90° 26' 40"
SSM 36242	153° 37' 49"	Copper spike	197° 03' 00"
Copper spike	238° 06'	Pillar	255° 47' 20"

Station	Direction	Station	Direction