


STATION TS10445 OXFORD FALLS


Owners Name..... Current Occupant.....

Address.....

Access (SEE WARRINGAH SHIRE COUNCIL) 28-11-1979
 FOR KEY
 00 ON WAREHURST PARKWAY TURN LEFT ON OXFORD FALLS RD
 01 CROSS OXFORD FALLS CROSSING (NEWER STUB)
 07 NEAR CREST VEER LEFT UP STEEP SEALED DRIVE
 08 AT FORK ON CREST VEER LEFT ALONG DIRT ROAD
 10 WHITE CEMENT RENDERED 4 FIBRO COTTAGE, CONTINUE
 ALONG THROUGH TWO GATES, PASS HORSE STABLES
 ON RIGHT, CONTINUE ALONG CLEARED CIRCUIT TO
 FIRST STEEL GATE. PARK VEHICLE AT 1.2 KM
 FOUR WHEEL DRIVE NEEDED PAST THIS POINT.
 (KEY REQUIRED FOR LAST GATE WARRINGAH SHIRE COUNCIL)

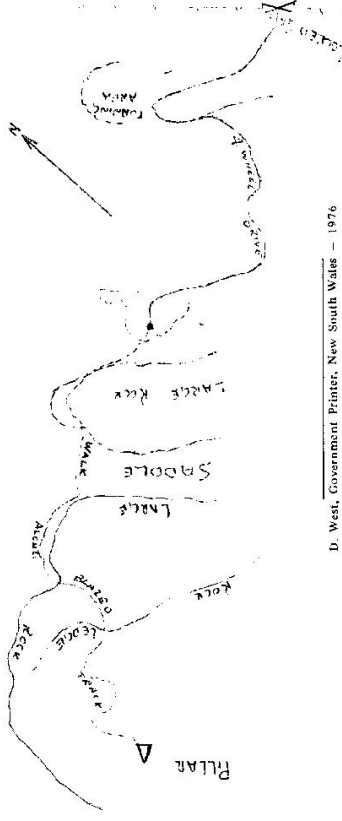

D. West, Government Printer, New South Wales - 1976

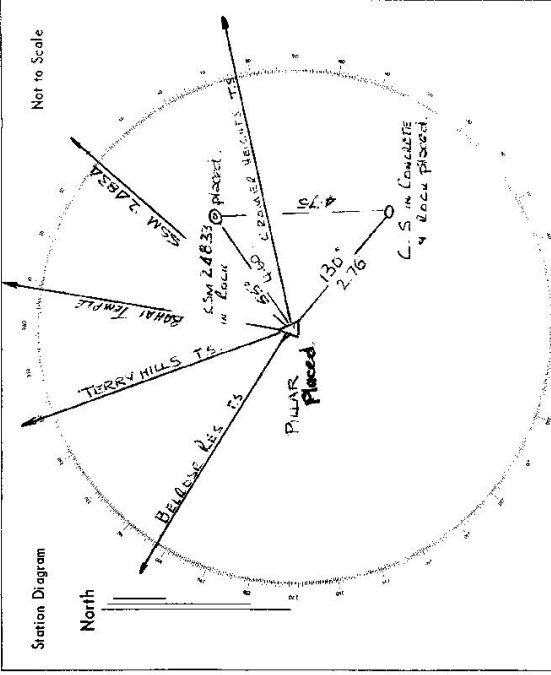

List of Observed Directions:- 15/1/76
 FOR: OXFORD FALLS TS
 Standpoint: OXFORD FALLS TS Standpoint: SSM 24833

Station	Direction	Station	Direction
BELMORE RES TS	300 40 000	TS OXFORD FALLS	0 00 00
TERRY HILLS TS	374 58 366	TS OXFORD FALLS	325 37 54
TS ELANDRA RES	19 30 441	SSM 24833	0 51
SSM 24833	32 42 049		
SSM 24832	84 18 588		

Station	Direction	Station	Direction
TS BELMORE	300 40 000		
TS 10445 TS (CONT)	224 16 214		
SSM 24833	19 28 241		
TS 10445 CSI	124 52 43		