





STATION TS (10446) MEGALONG (P)

Owners Name.....  
 Current Occupant.....  
 Address.....

CONVENTIONAL VEHICLE  
 Access 20-11-1979  
 Note Key to Locked gate can be obtained from Blue Mtns Council  
 (UNIVERSAL KEY)

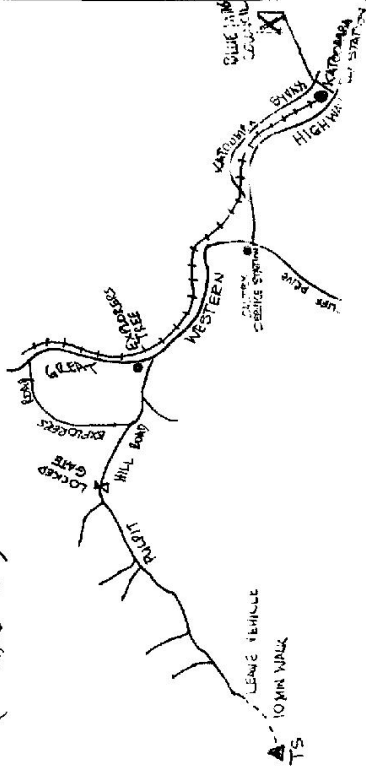

Station Diagram  
 Not to Scale

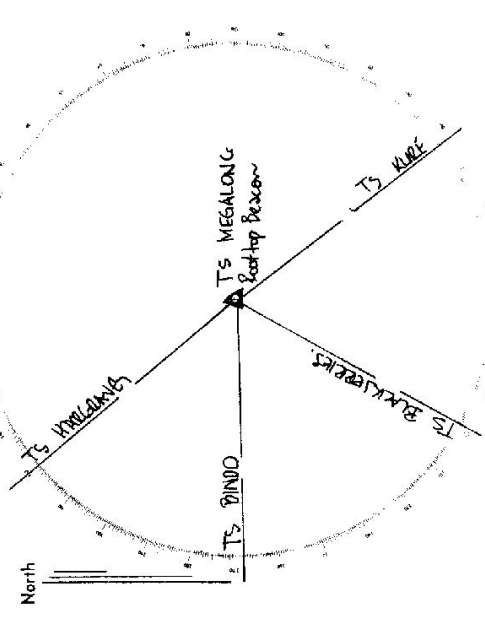

List of Observed Directions:-

Standpoint: Pillay		Standpoint:	
Station	Direction	Station	Direction
TS KURE	147° 00' 00"		
TS BLACKBERRIES	207° 54' 49"		
TS DINDO	266° 52' 52.5"		
TS WINDHAM	320° 33' 59.4"		
Station	Direction	Station	Direction