

Req: R194674 / Doc: TS 0010447 P / Rev: 10-Feb-2004 / Sts: NO.OK / Prt: 26-Aug-2011
 Ref: lpi: syd-spinksr / Src: W

TS10447

RECONNAISSANCE and MAINTENANCE REPORT


Integrating Survey of N.S.W.

Department of Lands

STATION CROMER HEIGHTS (P) T.C. 104
 Co: CUMBERLAND Ph: MANLY COUE

Map Sheet: FRENCHS FOREST UB60-VJ No: 1860
 Inspected by: IAN CARTER Date: 23-11-79
 Authority: Integration Survey Brand: Field Book: 2552

Beacon Diagram On Partion Not to Scale

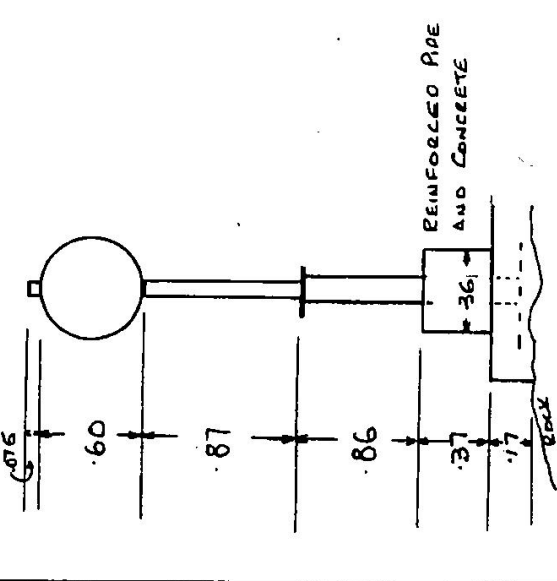


TS10447

Note: Cross out word or words which do not apply

1. Completely cleared to permit 360° vision to surrounding Trigs.
2. Cleared by lanes bearing 12.6° TO 138° from Trig. Mast
3. Trig. Mast & Vanes have been painted white & black respectively.
4. The Trig. was unpiled/not unpiled, dimensions now being: NEW PILLAR.
 Description of mark: ~~ROOF PILLAR IN CONCRETE~~ should be explicit, e.g. Steel plug, Brass plug, Bolt, Concrete Pillar
 Height of mark: 1.23 m above rock/concrete 1.40 m above G.L.
 Height of Top Vanes to ~~Top Mast~~ Top pillar plate 1.47 m Diameter of Vanes (vertical) 0.60 m.
 Height of Cairn: m. Diameter of Cairn: m.
 Length of Mast: m. (approximate if not unpiled)
5. A.S.M. 22526 set in ~~conc/rock~~ has been placed/ld 1.043 m. bearing 181° M from Trig. Mast/pillar
6. A. ~~set in conc/rock~~ has been placed/ld m. bearing °M from Trig. Mast/pillar
7. A.L.E.O.P. ~~set in conc/rock~~ has been placed/ld 3.230 m. bearing 206° M from Trig. Mast/pillar
8. A. ~~set in conc/rock~~ has been placed/ld m. bearing °M from Trig. Mast/pillar
9. Connection T.S. to SSM 1.043 m. bearing 181° M
10. Connection T.S. to ~~SSM~~ A. 3.230 m. bearing 206° M
11. Connection to m. bearing °M
12. Connection to m. bearing °M
13. Diff. Hr. SSM 22526 is 1.43 m. above below PILLAR PLATE
14. Diff. Hr. LEAD PLUG (1) is 1.87 m. above below PILLAR PLATE
15. Diff. Hr. SSM 22526 is 1.44 m. above below LEAD PLUG AS IN (7)
16. Diff. Hr. is m. above below

Date	Record of Stat
23-11-79	Pillar erected

Prepared by: I. Carter Checked: *[Signature]*

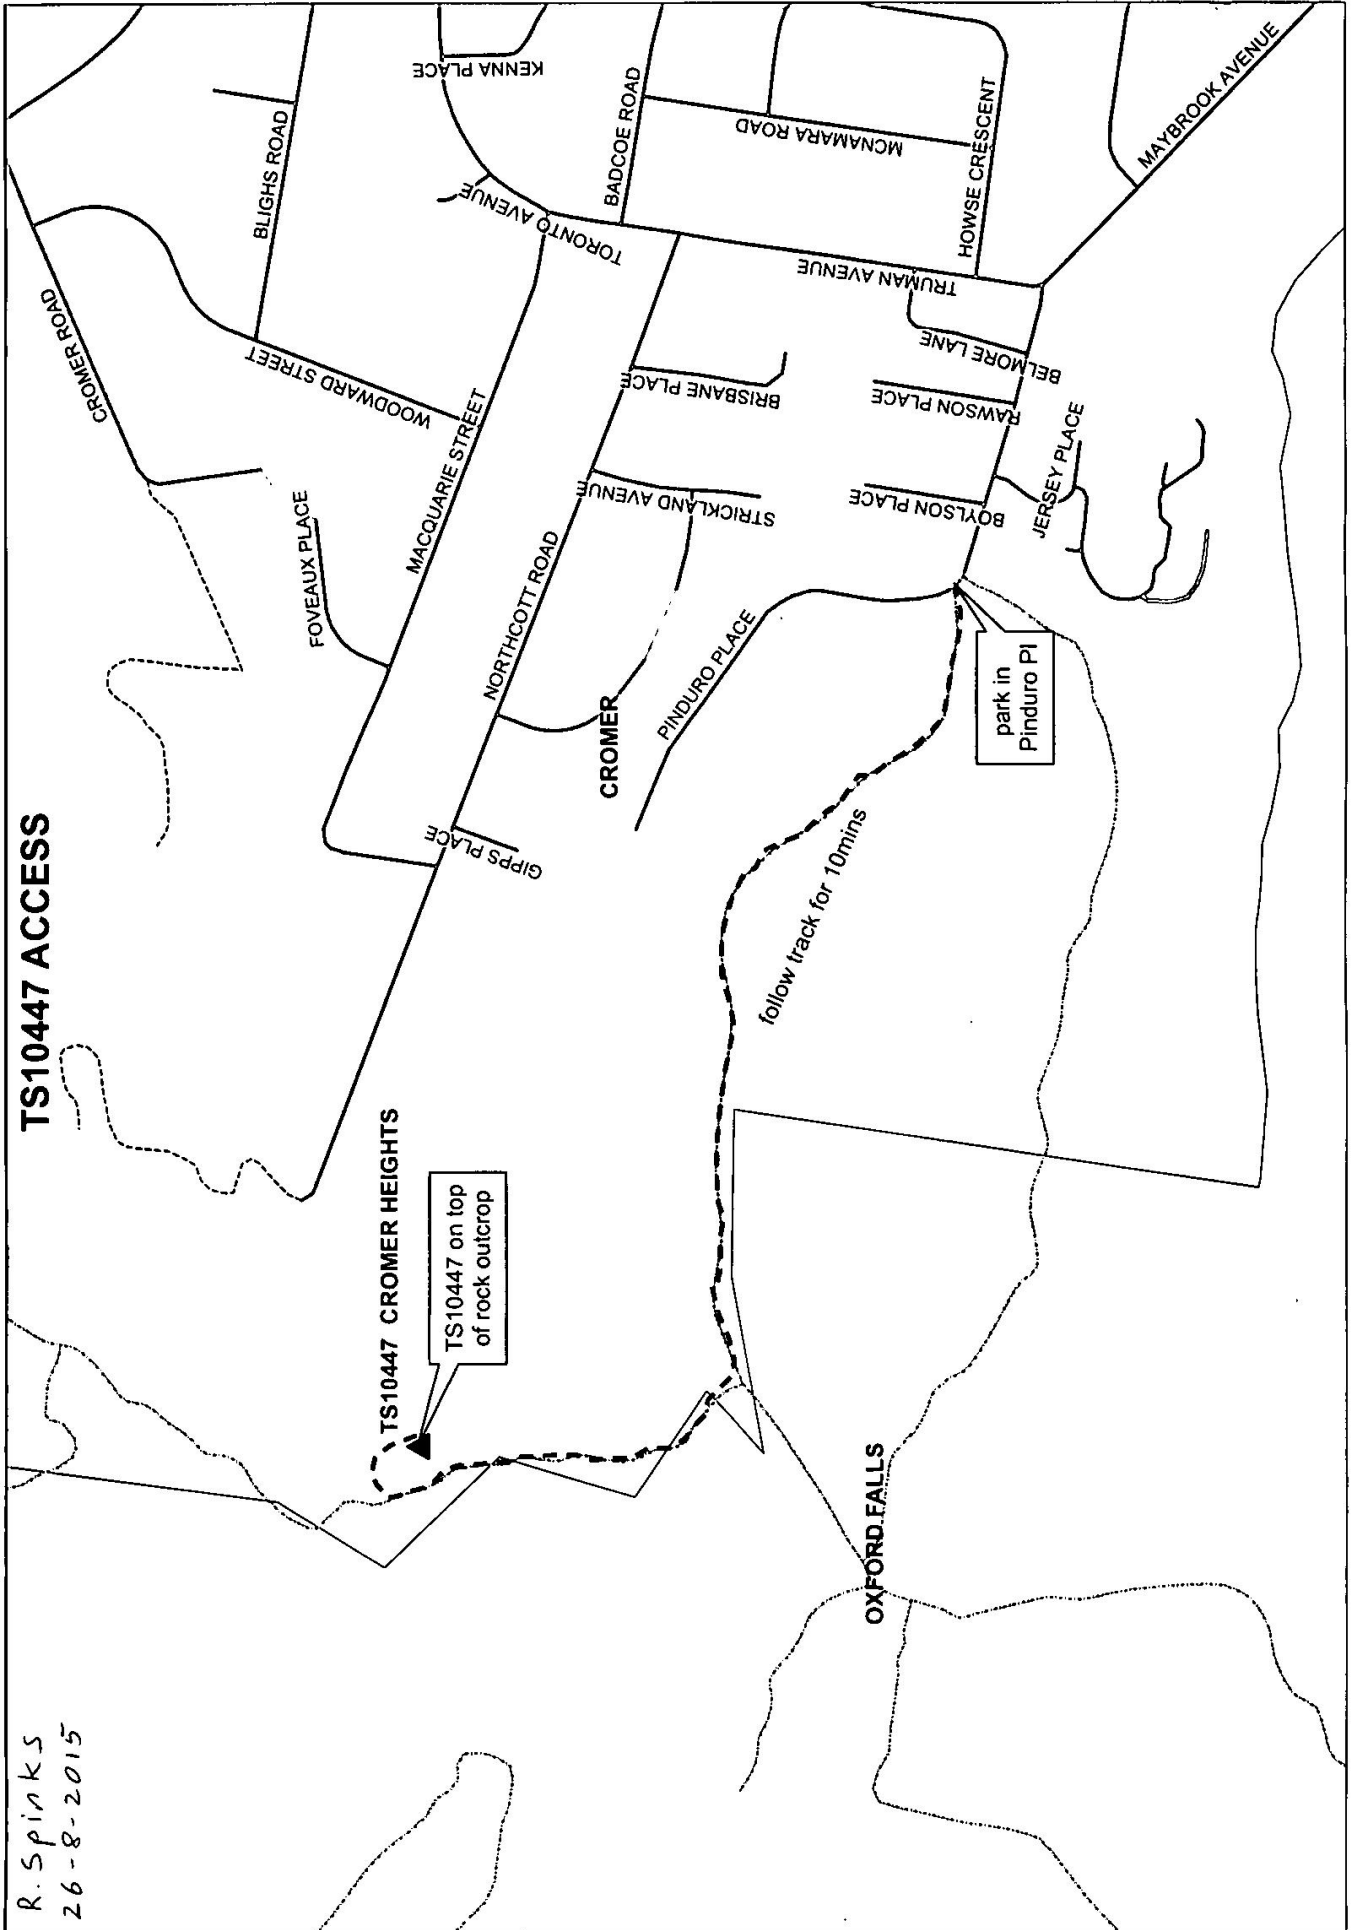

TS10447 ACCESS

R. Spinks
26-8-2015

Req:R194674 /Doc:TS 0010447 P /Rev:10-Feb-2004 /Sts:NO.OK /Prt:26-Aug-2015 11:34 /Pgs:ALL /Seq:2 of 2
 Ref:lpi:syd-spinker /Src:W


STATIONS 10447 CROMER HEIGHTS (P)

Owners Name.....
 Current Occupant.....


Address.....
 Address.....

Access 23-11-1979

Not to Scale

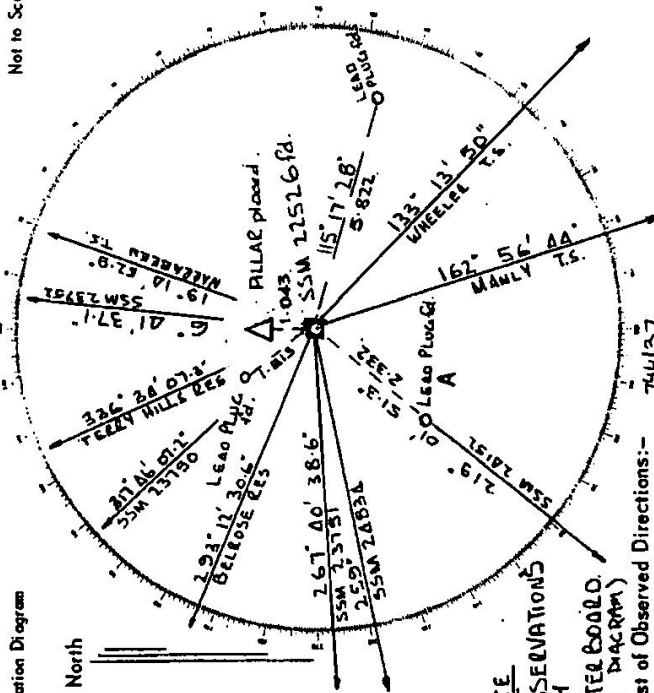

Station	Direction	Station	Direction
OXFORD FALLS TS	243 55 27	NEWPORT HTS TS	17 56 43
BELROSE TS	277 00 00	BUSH RANGER TS	21 27 09
TERREY HILLS TS	300 04 25	WHEELER TS	116 59 27
BAHRA TEMPLE TS	347 00 03	MANLY TS	146 27 43
ELANGRA TS	2 10 40		
CROMER HTS TS	FDBI 744/37		
TERREY HILLS TS	335 00 00		
MANLY TS	161 23 20		
SSM 22526	181 15 43		
LEAD PLUG A (SSM 151)	206 30 0		

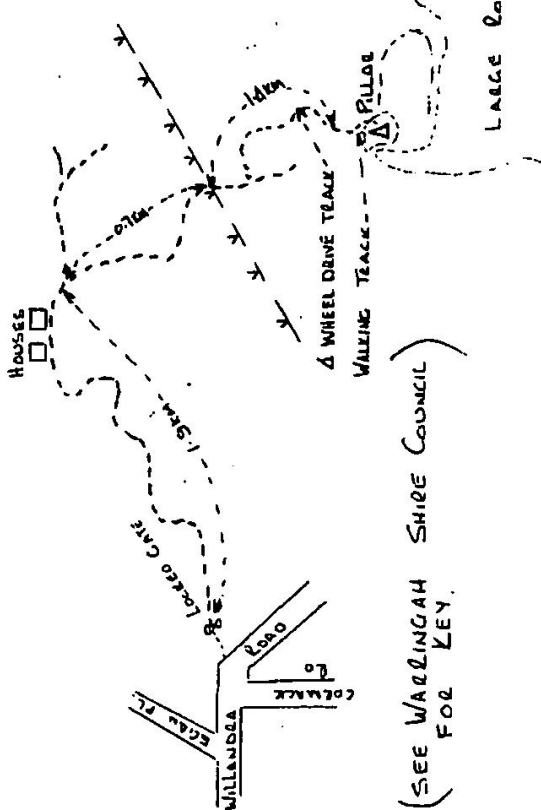

(SEE WALLINGGAH SHIRE COUNCIL FOR KEY)

D. West, Government Printer, New South Wales - 1976