

7/5/02

Department of Lands

Integrating survey of N.S.W.

RECONNAISSANCE and MAINTENANCE REPORT

This Trig. Station has been:-

Note: Cross out word or words which do not apply

1. Completely cleared to permit 360° vision to surrounding Trigs. ✓

2. ~~Cleared by lines bearing~~ ✓

3. Trig. Mast & Vanes have been painted white & black respectively. ✓

4. The Trig. was unpiled/~~not unpiled~~, ~~dimensions now being~~ ✓

Description of mark..... should be explicit, e.g. Steel plug, Brass plug, Bolt, Concrete Pillar

Height of mark..... m above rock, concrete m below G.L.

Height of Top Vanes to ~~Top mark~~ Top pillar plate 1.40 m Diameter of Vanes (vertical) 0.60 m.

Height of Conn..... m Diameter of Conn..... m.

Length of Mast 1.40 m. (approximate if not unpiled)

5. ~~ASSUMED~~ ~~set~~ in conc/rock has been placed at 6.76 m. bearing 74° M from Trig. Mast/pillar

* ~~Copper~~ ~~set~~ in conc/~~set~~ has been placed at 5.99 m. bearing 302° M from Trig. Mast/pillar

6. ~~Aspike~~ ~~set~~ in conc/~~set~~ has been placed at 5.99 m. bearing 302° M from Trig. Mast/pillar

7. A..... set in conc/soil has been placed at m. bearing M from Trig. Mast/pillar

8. A..... set in conc/rock has been placed at m. bearing M from Trig. Mast/pillar

9. Connection to..... m. bearing M * See FB41 Summary For Book G4B/02

10. Connection to..... m. bearing M

11. Connection to..... m. bearing M

12. Connection to..... m. bearing M

13. Diff. Ht. 55M 246.87 is 1.912 m. ~~below~~ Pillar Plate

14. Diff. Ht. Copper Spike is 1.699 m. ~~below~~ Pillar Plate.

15. Diff. Ht. is m. above

16. Diff. Ht. is m. below

Prepared by: H. S. Healsman Checked: EE

STATION TS 10449 EGAN. (P)


Co: Pottinger Ph:

Map Sheet: Wandoba No: 8934-IV-N

Inspected by: H. S. Healsman Date: 10/11/77

Authority: DEPT OF LANDS Field Book: G4B/02

Beacon Diagram

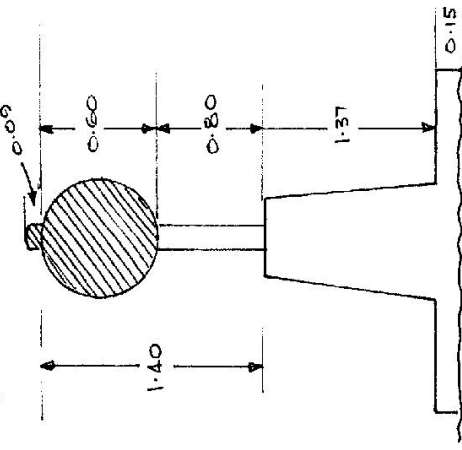

| Date | Record of Station |
|-------------|-------------------|
| Nov 17 1977 | Pillar Erected. |
| | Name Plate Placed |
| | |
| | |
| | |

