

Department of Lands **Non-Geodetic** Reconnaissance and Maintenance Report

Integrative Survey of N.S.W

This Trig. Station has been:-

1. Completely cleared to permit 360° vision to surrounding Trigs.
2. Cleared by lanes bearing..... from Trig. Mast
3. Trig-Mast & Vanes have been painted white & black respectively.
4. The Trig. was unpiled/not unpiled, dimensions now being:

Description of mark: **Top of steel radio tower** should be explicit, e.g. Steel plug, Brass plug, Bolt, Concrete Pillar

Height of mark..... m above rock-concrete **40** m above below G.L.

Height of Top-Vanes to Top-Mark/Top-pillar-plate..... m Diameter of Vanes (vertical)..... m

Height of Cairn..... m Diameter of Cairn..... m

Length of Mast..... m (approximate if not unpiled)

5. A..... set in conc/rock has been placed/rd..... m, bearing.....°M from Trig. Mast/pillar
6. A..... set in conc/soil has been placed/rd..... m, bearing.....°M from Trig. Mast/pillar
7. A..... set in conc/soil has been placed/rd..... m, bearing.....°M from Trig. Mast/pillar
8. A..... set in conc/rock has been placed/rd..... m, bearing.....°M from Trig. Mast/pillar

9. Connection..... to..... m, bearing.....°M

10. Connection..... to..... m, bearing.....°M

11. Connection..... to..... m, bearing.....°M

12. Connection..... to..... m, bearing.....°M

13. Diff. Ht. is..... m, above below

14. Diff. Ht. is..... m, above below

15. Diff. Ht. is..... m, above below

16. Diff. Ht. is..... m, above below

Prepared by: **B.J. Gamlin T.S.** Checked: **[Signature]**

STATION TS 10451 PHILIPS PROSPECT TWIR

Co: Cumberland

Ph: Prospect

Map Sheet: DENR/174

No: 9030

Inspected by: E. Gamlin


Date: 1.12.17

Authority: Integration

Field Book: PPP 650

Beacon Diagram

Not to Scale

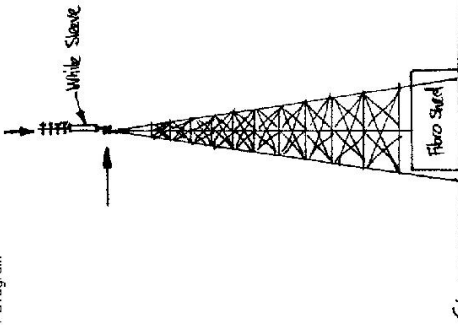

Date	Record of Station
9/11/17	Station connected

