





Integration of N.S.W.

RECONNAISSANCE and MAINTENANCE REPORT IC453

Department of Lands

This Trig. Station has been:-

1. Completely cleared to permit 360° vision to surrounding Trigs.
2. Cleared by lanes bearing ~~AS. RES. 2015 RAN~~ from Trig. Mast
3. Trig. Mast & Vanes have been painted white & black respectively.
4. The Trig. was emptied/not unplied, dimensions now being:

Description of mark... **CONCRETE PILLAR** should be explicit, e.g. Steel plug, Brass plug, Bolt, Concrete Pillar  
 Height of mark... **PILLAR PLATE 1.27m** <sup>above</sup> ~~below~~ **concrete** 1.50 m <sup>above</sup> ~~below~~ G.L.  
 Height of Top Vanes to Top Mast/Top pillar plate 1.31 m Diameter of Vanes (vertical) 0.6 m.  
 Height of Cairn ..... m. Diameter of Cairn ..... m.

Length of Mast ..... m. (approximate if not unplied)

5. A. **BOLT 'A'** set in ~~conc/rock~~ **rock** has been placed/d 4.434 m. bearing 62 ..... °M from Trig. ~~Mast~~ pillar
6. A. **DRILL HOLE** set in ~~conc/rock~~ **rock** has been placed/d 4.998 m. bearing 98 ..... °M from Trig. ~~Mast~~ pillar
7. A. **BOLT 'B'** set in ~~conc/rock~~ **rock** has been placed/d 2.533 m. bearing 223 ..... °M from Trig. ~~Mast~~ pillar
8. A ..... set in ~~conc/rock~~ **conc/rock** has been placed/d ..... m. bearing ..... °M from Trig. ~~Mast~~ pillar

9. Connection ..... to ..... m. bearing ..... °M

10. Connection ..... to ..... m. bearing ..... °M

11. Connection ..... to ..... m. bearing ..... °M

12. Connection ..... to ..... m. bearing ..... °M

13. Diff. Ht. .... is ..... m. <sup>above</sup> ~~below~~ .....

14. Diff. Ht. .... is ..... m. <sup>above</sup> ~~below~~ .....

15. Diff. Ht. .... is ..... m. <sup>above</sup> ~~below~~ .....

16. Diff. Ht. .... is ..... m. <sup>above</sup> ~~below~~ .....

Prepared by: **L.G. TREVERROW** Checked: .....

STATION **TS HANGERS ROCK (P)**


Co: **CAMDEN** Ph: **DENDROBIUM**

Map Sheet: **BARGO** No: **9001A III N**

Inspected by: **L.G. TREVERROW** Date: **2-8-78**

Authority: **DEPARTMENT OF LANDS** Field Book: **H.J. GREEN**

Beacon Diagram

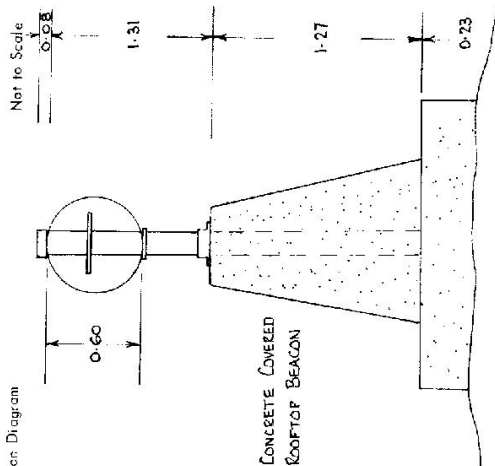

Date: ..... Record of Station  
**4-9-76 BEACON ERECTED H.J. GREEN**  
**29-9-76 CONNECTIONS READ H.J. GREEN**  
**FEB 1978 BEACON SET IN CONCRETE A.L.S.**


STATION TS HANGERS ROCK

Current Occupant: M.W.S. & D.B.

Owners Name:

Address:

Station Diagram

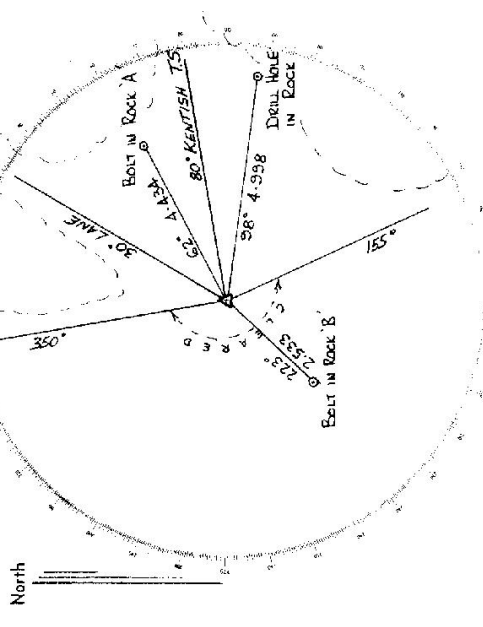

List of Observed Directions:-

Standpoint: FILLAR		Standpoint:	
Station	Direction	Station	Direction
T.S. KENTISH	0° 00' 00"		
DRILL HOLE	13 04 03		
BOLT B	123 31 48		
BOLT A	334 51 48		
Station	Direction	Station	Direction

