



STATION TS 10461 TEA GARDENS (P) 10461

Current Occupant.....

Address.....


Owners Name.....

Address.....

Access 30-8-1977

Verhule

- 0-0 Ithun Tea Gardens Road and Pacific Highway north of Karuah. Take Tea Gardens - Newcastle West Road.
- 6-8 Turn left onto gravel road at "Lion Park" picnic area.
- 7-55 Water Tank on R.H.S.

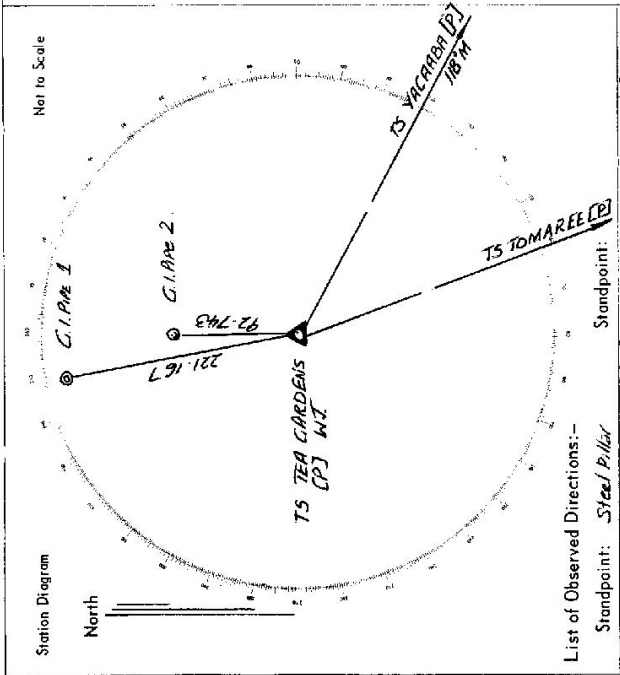

List of Observed Directions:-

Station	Direction	Station	Direction
TS YALCARABA (P)	118° 00' 00"		
TS TOMAREE (P)	161° 32' 55"		
G.P1	321° 14' 17"		
G.P2	329° 32' 37"		

Station	Direction	Station	Direction

Note: Adapter required from ISD - Newcastle PL 69-1669 to enable instrument to be set on pillar.

TRIG MAINTENANCE REPORT  
CONTROL DIAGRAM  
CENTRAL MAPPING AUTHORITY

MAP SHEET FORT STEPHENS  
No 9332

STATION 9332-0554-TS  
TEA GARDENS TS 10461


Survey I Robins  
No. 25-1-83  
Reference  
Photo Identification  
RUB. NSW  
Field Books R226 F125


Station Name	Work	Direction	Horiz. Distance	Height	Difference
G.I. Pipe 2	G.I. Pipe	320°M	92.743	9.402	

Station: Removable pillar, Plate  
AHD Elevation: 77.527  
Plate: 77.527  
Field Books: R226 F125

STATION NAME	STATION COORDINATES		AHD GROUND ELEVATION
	ZONE	EASTING	
TEA GARDENS TS (P) 9332-0554-TS	56/2	220058.977	1387490.307
	56	420086.159	6388719.634
	56/1	407722.555	1387229.783
Coordinates Adopted From M.M.S.			

Reference: CLO 78016  
Compound: 44  
Date: 1-6-83  
Checked: [Signature]  
Date: 5-2-83  
Checked: [Signature]  
Date: [Signature]  
Date: [Signature]

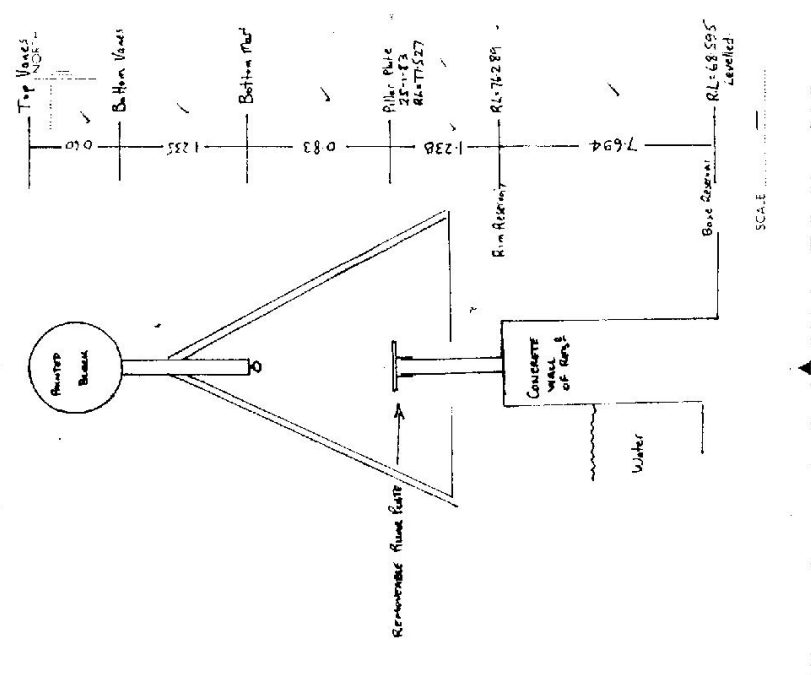

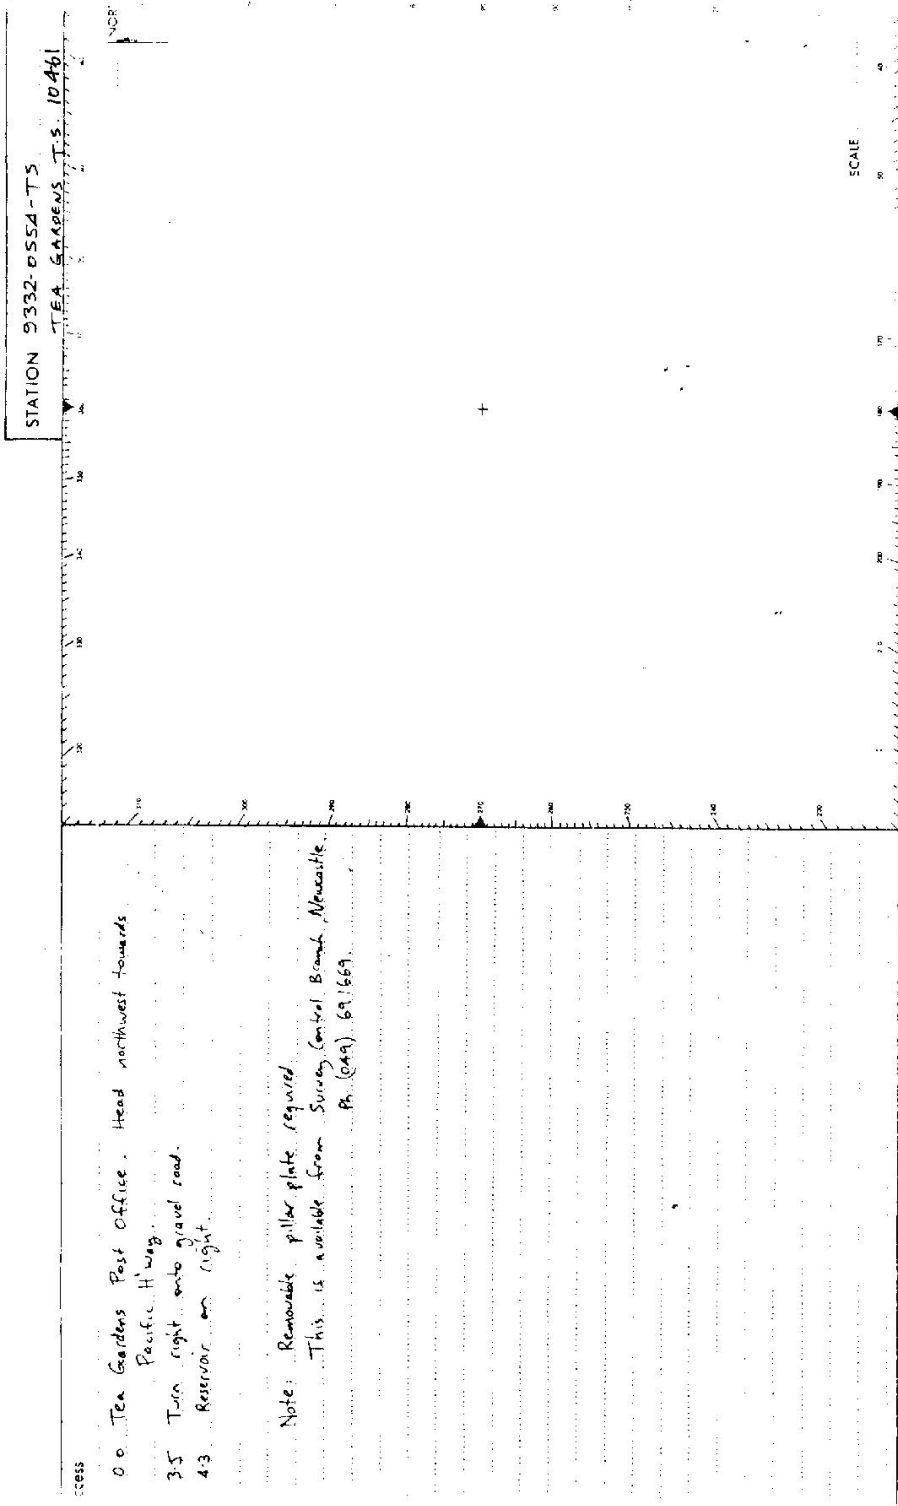

STATION 9332-0554-T3  
TEA GARDENS TS 10461

Cross

0.0 Tea Gardens Post Office. Head northwest towards Pacific Hwy.  
 3.5 Turn right onto gravel road.  
 4.3 Reservoir on right.

Note: Removable pillar plate required.  
 This is available from Survey Central Branch, Newcastle.  
 Ph. (049) 691669.

SCALE

