

STATIONTS 10467 ROSEMEADOW (P)


Current Occupant.....

Address.....

Owners Name.. M. W. S. & D. B.


Address.....

Access See CAMPBELLTOWN 1:25000 Map August 1981

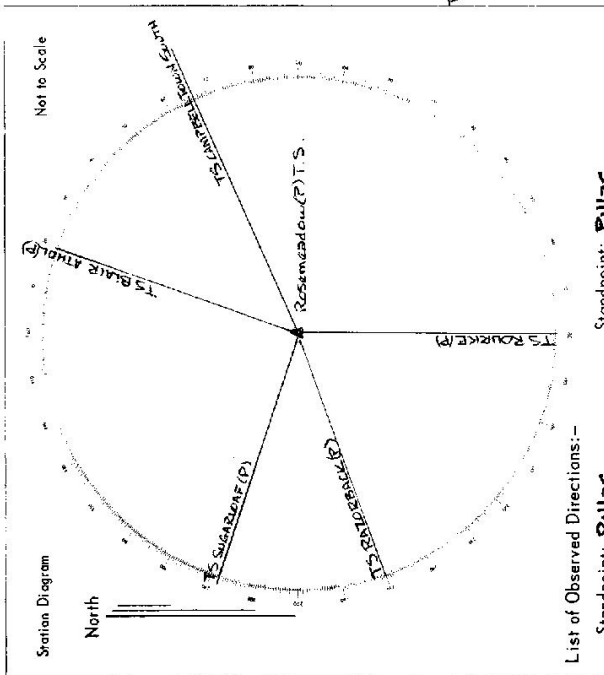

List of Observed Directions:-

Standpoint: Pillar		Standpoint: Pillar	
Station	Direction	Station	Direction
TS SUGARLOAF (P)	0° 00' 00"	TS ROURKE (P)	0° 00' 00"
TS BLAIR ATHOL (P)	90° 48' 47"	TS RAZORBACK (P)	70° 53' 23"
TS CAMPBELLTOWN SOUTH	135° 40' 57"	TS SUGARLOAF (P)	108° 32' 30"

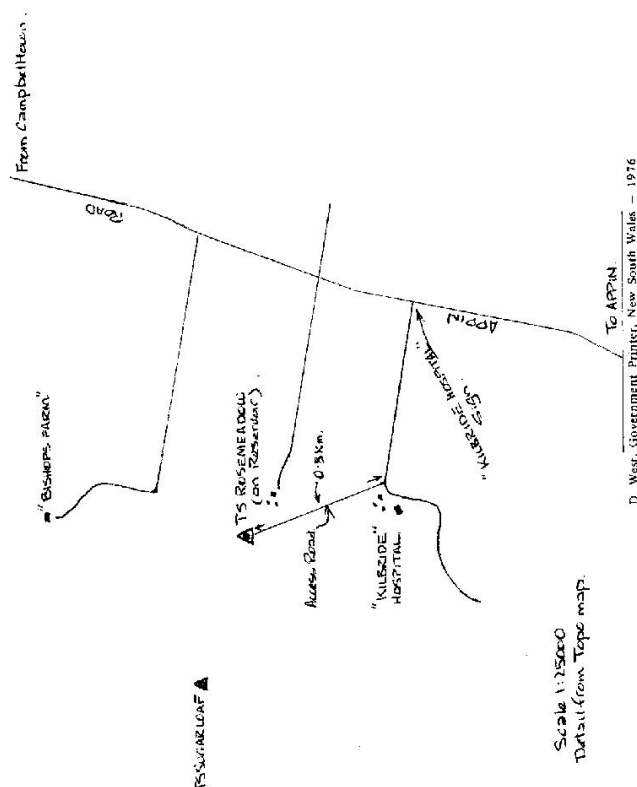

Scale 1:25000
Detail from Topo map.

D. West, Government Printer, New South Wales - 1976

STATIONTS 10467 ROSEMEADOW (P)


Current Occupant.....

Address.....

Owners Name: M. W. S. D. B.....


Address.....

Access See CAMPBELLTOWN 1:25000 Map August 1981

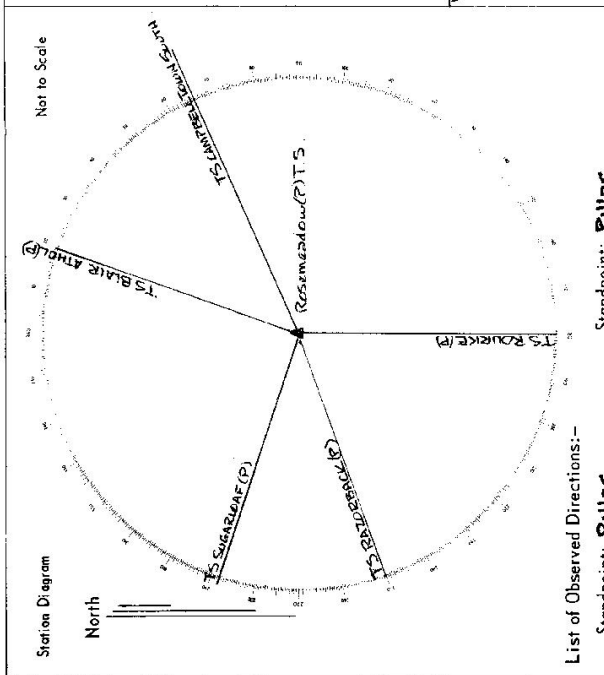

List of Observed Directions:-

Standpoint: Pillar		Standpoint: Pillar	
Station	Direction	Station	Direction
TS SUGARLOAF (P)	0° 00' 00"	TS ROURKE (P)	0° 00' 00"
TS BLAIR ATHOL (P)	90° 48' 47"	TS RAZORBACK (P)	70° 53' 23"
TS CAMPBELLTOWN SOUTH	135° 00' 57"	TS SUGARLOAF (P)	108° 32' 30"
Station	Direction	Station	Direction

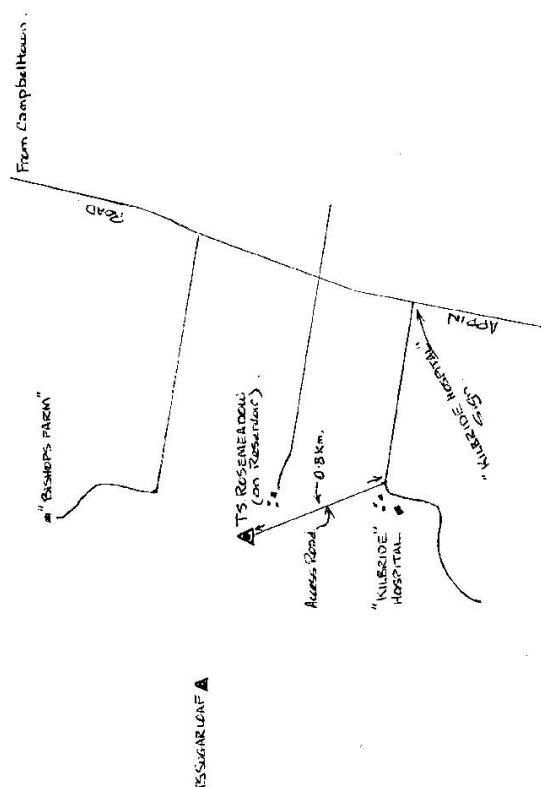

Scale 1:25000
Detail from Topo map.

D. West, Government Printer, New South Wales - 1976