

7-5-10-8

Department of Lands


Integral Survey of N.S.W.

Non-ventilating RECONNAISSANCE and MAINTENANCE REPORT

STATION **TS 201306 Pillar (10470)**

Co: **Northumberland** Ph: **No 10406 C**
 Map Sheet: **Bullgo** No: **9132**
 Inspected by: **AR Graham** Date: **A-12-77**
 Authority: **ISD NCLE** Field Book: **PPP 553**

Beacon Diagram

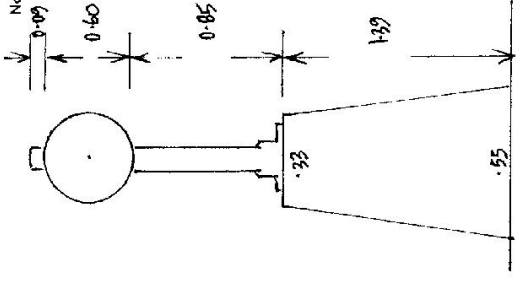

Note: Cross out word or words which do not apply

This Trig. Station has been:

1. Completely cleared to permit 360° vision to surrounding trigs. ✓
2. Cleared by ~~James-bearing~~ **from Trig-Mast**
3. Trig. Mast & Vanes have been painted white & black respectively. ✓
4. The Trig. was unpiled/~~not unpiled~~, dimensions now being:
 - Description of mark: **Concrete pillar** should be explicit, e.g. Steel plug, Brass plug, Bolt, Concrete Pillar
 - Height of mark: ~~1.39~~ **1.39** m ^{above}/_{below} **rock-concrete** ^{above}/_{below} G.L.
 - Height of Top Vanes to ~~Top Mast~~ Top pillar plate: **1.45** m Diameter of Vanes (vertical): **0.60** m.
 - Height of Cairn: **1.32** m. Diameter of Cairn: **33 x .55** m.
 - Length of Mast: **1.54** m. (approximate if not unpiled)
5. **SSM24287** set in conc/~~rock~~ has been placed/~~is~~ **7.76** m. bearing **298**°M from Trig. ~~Mast~~ pillar
6. ~~Carrier Spike~~ set in conc/~~soil~~ has been placed/~~is~~ **6.315** m. bearing **178**°M from Trig. ~~Mast~~ pillar
7. A..... set in conc./soil has been placed/~~is~~..... m. bearing.....°M from Trig. ~~Mast~~ pillar
8. A..... set in conc./rock has been placed/~~is~~..... m. bearing.....°M from Trig. ~~Mast~~ pillar

9. Connection: **SSM24287** to **C.S.** : **11.807** m. bearing **146**°M
10. Connection:..... to..... m. bearing.....°M
11. Connection:..... to..... m. bearing.....°M
12. Connection:..... to..... m. bearing.....°M
13. Diff. Ht. **Pillar Plate** is **1.714** m. ^{above}/_{below} **SSM24287**
14. Diff. Ht. **Pillar Plate** is **1.677** m. ^{above}/_{below} **C.S.**
15. Diff. Ht. **SSM24287** is **0.049** m. ^{above}/_{below} **C.S.**
16. Diff. Ht. is..... m. ^{above}/_{below}

Prepared by: **AR**

Checked:

| Date | Record of Station |
|---------------|-----------------------|
| Dec 77 | Pillar Erected |
| | |
| | |
| | |
| | |

STATION TS ~~10470~~ Pillar 10470


Owners Name.....
 Current Occupant.....
 Address.....

Access 4-12-1977

km. Feature

0.0 Smaleton PO - Travel towards Pully ~~to~~ along Pully Road.
 11.0 Here Pully Road and Broke Road (2nd turn-off)
 Return towards Aungstetow 0.45 km, wire gate on S-East side
 of road - follow faint track to trig 0.2 km from gate.

Access by conventional vehicle.

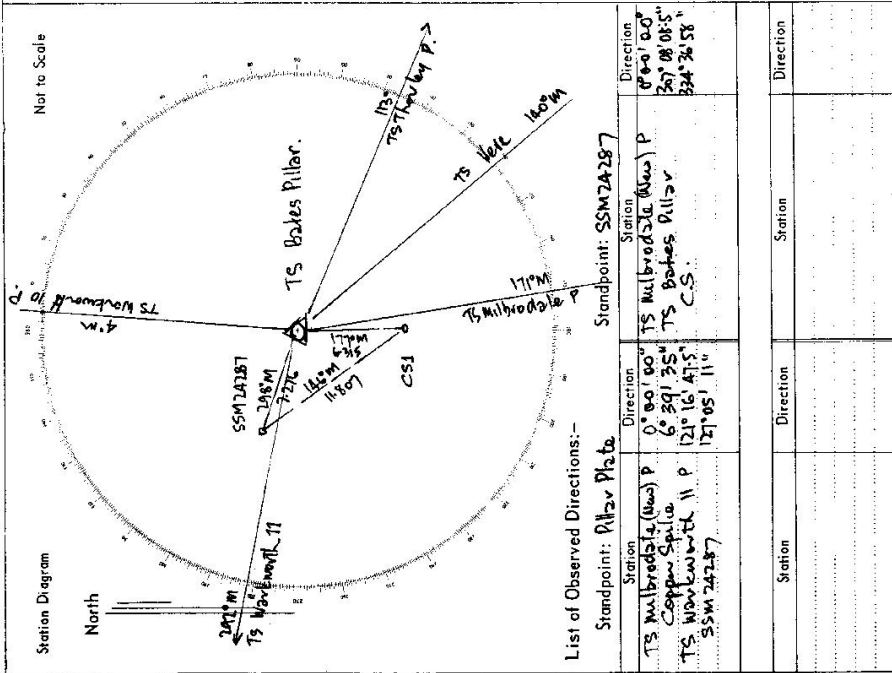

D. West, Government Printer, New South Wales - 1976

