



STATION TS  
 10473  
 WOODBOON PILLAR


Owners Name: Homegar Current Occupant: OWNER

Address: "Woodburn" Address: .....

Nr. Muirwellbrook

- Access 23-11-1977  
Private
- 0-0 Muirwellbrook P.O. - Follow Num. England Highway Towards Seeme
  - 1-0 Turn left onto Seeme (bellow) Road.
  - 1-6 Turn right over Hunter River - follow road to Kayupoo + Aberdeen.
  - 6-0 Pass Castle Rock Road on L.H.S.
  - 7-9 Turn left onto buteman road.
  - 10-5 Right turn.
  - 10-9 Right angle hand to left.
  - 11-8 " " " right - pass removed more right angle bands.
  - 14-9 Natural dry ford.
  - 15-6 " " "
  - 16-0 Turn right into gate opposite homestead known as "Woodburn"  
 follow track to fence  
 Trig.

Conventional vehicle access.

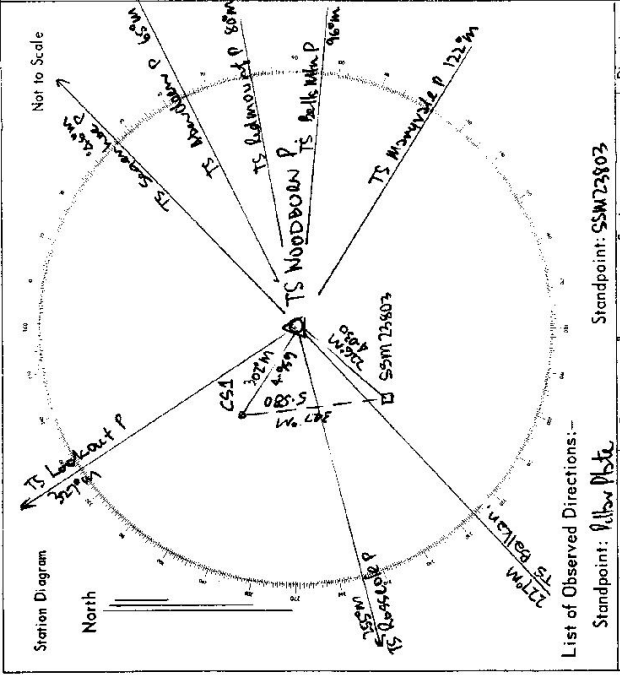

List of Observed Directions:-

Standpoint: Willow Pt. C		Standpoint: SSM 23803	
Station	Direction	Station	Direction
TS Ballewin P	0° 09' 00"	TS Woodburn P	0° 00' 00"
TS Rosevale P	28° 10' 39"	Copper Spile	308° 25' 57"
Copper Spile	75° 50' 34.5"		
SSM 23803	75° 52' 37.5"		