

75-19

Department of Lands **Non-Geodetic** Integrative Survey of N.S.W. **RECONNAISSANCE and MAINTENANCE REPORT**

STATION **TS BATEAU BAY W/T P. 10476**
 Co: **Northumberland** Ph: **Tugdewick**
 Map Sheet: **Gosford** No: **9131**
 Inspected by: **P. McPeck** Date: **17.8.77**
 Authority **ISD NULE** Field Book: **PPP 508**
 Beacon Diagram **Not to Scale**

Note: Cross out word or words which do not apply

This Trig. Station has been:


1. Completely cleared to permit 360° vision to surrounding Trigs. ✓
2. Cleared by ~~James bearing~~ **from Trig-Mast** ✓
3. Trig. Mast & Vanes have been painted white & black respectively. ✓
4. The Trig. was unpiled/~~not-unpiled~~, dimensions now being:

Description of mark **Steel pillar** should be explicit, e.g. Steel plug, Brass plug, Bolt, Concrete Pillar
 Height of mark ~~..... m. above rock-concrete~~ **20.76** m above G.L.
 Height of Top Vanes to ~~Top~~ **Top** pillar plate **1.45** m Diameter of Vanes (vertical) **0.60** m.
 Height of Cairn **1.36** m. Diameter of Cairn **125** m.
 Length of Mast **1.54** m. (approximate if not unpiled)

5. A..... set in conc./rock has been placed/fd m. bearing°M from Trig. Mast/pillar
6. A..... set in conc./soil has been placed/fd m. bearing°M from Trig. Mast/pillar
7. A..... set in conc./soil has been placed/fd m. bearing°M from Trig. Mast/pillar
8. A..... set in conc./rock has been placed/fd m. bearing°M from Trig. Mast/pillar

9. Connection..... to..... m. bearing.....°M
10. Connection..... to..... m. bearing.....°M
11. Connection..... to..... m. bearing.....°M
12. Connection..... to..... m. bearing.....°M
13. Diff. Ht. is..... m. above below
14. Diff. Ht. is..... m. above below
15. Diff. Ht. is..... m. above below
16. Diff. Ht. is..... m. above below

Prepared by **[Signature]** Checked:

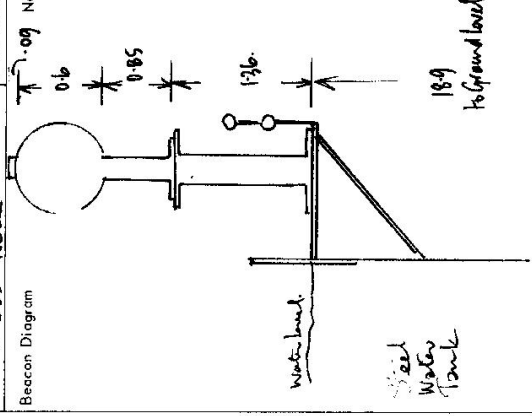


Date	Record of Station
17/8/77	Beacon Erected by Wyong Shire Council

STATION TS BATEAU BAY W/T P. 10476

Owners Name: Wyong Shih Current Occupant: Shonan

Address: Wyong Address:

Access 17-8-77
Berne St - Bateau Bay.
Key for gate + ladder available from
Wyong Shih Depot - Bateau Bay.
(near High School)

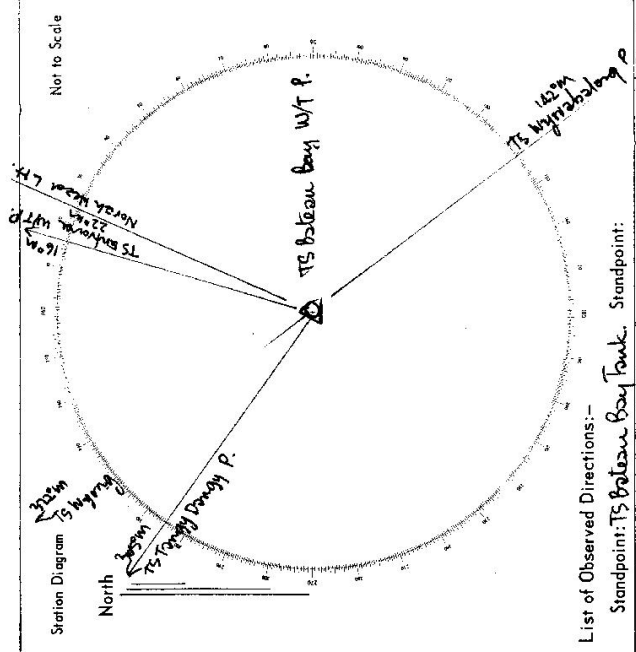

List of Observed Directions:-

Stationpoint: TS Bateau Bay Tank.		Standpoint:	
Station	Direction	Station	Direction
TS Wyong P	322° 00' 00"	TS Wyong W/T P	16° 51' 20"
TS Bateau Bay W/T P	22° 25' 21"	Norah Head L/H	142° 11' 00"
TS Wyong Shih W/T P	308° 29' 40"	TS Wyong Shih W/T P	
TS Wyong Shih W/T P		TS Wyong Shih W/T P	