

GEODETTIC SURVEY OF N.S.W.

CENTRAL MAPPING AUTHORITY

GEODETTIC STATION RECONNAISSANCE and MAINTENANCE REPORT

- Description:
- Cleared by ~~James-bearing~~ *all around*. Note: Cross out word or words which do not apply
  - Mast & Vanes have been painted white & black respectively, in cairn of rocks found
  - The station/pillar was unpiled/not unpiled/constructed on.....19....., dimensions now being:
- Description of mark.....should be explicit, e.g., S/Steel Pillar Plate, Steel plug, Brass plug, Bolt, G.I. Pipe
- Height of mark.....m. <sup>above</sup>/<sub>below</sub> rock/concrete; Mark is.....m. <sup>above</sup>/<sub>below</sub> G.L.
- Height of Top Vanes to Top Mark/Pillar plate .....m. Diameter of Vanes (vertical).....m.
- Height of Cairn.....m. Diameter of Cairn.....m. Name Plate found/not found/placed.
- Length of Mast.....m. (approximate if not unpiled)
- A.....set in conc/rock has been placed/found, bearing.....°M from Mast/Plug/Pillar
  - A.....set in conc/rock has been placed/found, bearing.....°M from Mast/Plug/Pillar
  - A.....set in conc/rock has been placed/found, bearing.....°M from Mast/Plug/Pillar
  - A.....set in conc/rock has been placed/found, bearing.....°M from Mast/Plug/Pillar
8. Action required:.....

STANDPOINT:

Mark	Direction	Horiz. Distance	Height Difference	Mark	Direction	Horiz. Distance	Height Difference
			above standpt.				above standpt.
			below standpt.				below standpt.
			above standpt.				above standpt.
			below standpt.				below standpt.
Prepared by: *P.K. Bamala* Checked: *Checked*  
 Noted on U.T.M. Card

STATION: *Bond* No.: *1049*

MAP SHEET SCALE 1:250 000 *Canberra*

INSPECTED BY: *P.K. Bamala* DATE: *May 19*

AUTHORITY: *CMA* FIELD BOOK:



CENTRAL MAPPING AUTHORITY

GEODETIC SURVEY OF M.S.W.

GEODETIC STATION RECONNAISSANCE and MAINTENANCE REPORT

STATION: **BOND** No.: **1049**  
 MAP SHEET SCALE 1:250 000 **CAMBERRA**  
 INSPECTED BY: **R. ELLIS** DATE: **17/9/81**  
 AUTHORITY: **L.M.A.** FIELD BOOK: **L0136**

- Description: *Note: Cross out word or words which do not apply*
- ~~Cleared by tenes-bearing~~ **HILL COMPLETELY CLEAR** from Trig. Mast
  - ~~Mast & Vanes have been painted white & black respectively.~~
  - The station/pillar was ~~unpiled/conserved~~ on **17/9/1981**, dimensions now being: Description of mark should be explicit, e.g., S/Steel Pillar Plate, Steel plug, Brass plug, Bolt, G.I. Pipe  
 Height of mark **.....**m. <sup>above</sup> rock/concrete; Mark is **.....**m. <sup>above</sup> below G.L.  
 Height of Top Vanes to Top Mark/Pillar plate **.....**m. Diameter of Vanes (vertical) **.....**m.  
 Height of Cairn **.....**m. Diameter of Cairn **.....**m. Name Plate found/not found/placed.  
 Length of Mast **.....**m. (approximate if not unpiled)
  - A **.....** set in conc/rock has been placed/found, bearing **.....**° M from Mast/Plug/Pillar
  - A **.....** set in conc/rock has been placed/found, bearing **.....**° M from Mast/Plug/Pillar
  - A **.....** set in conc/rock has been placed/found, bearing **.....**° M from Mast/Plug/Pillar
  - A **.....** set in conc/rock has been placed/found, bearing **.....**° M from Mast/Plug/Pillar
  - Action required: **MAPPING PURPOSES ONLY - HILL SURROUNDED BY RUBES.**

STANDPOINT:

Mark	Direction	Horiz. Distance	Height Difference	Mark	Direction	Horiz. Distance	Height Difference
			above standpt.				above standpt.
			below standpt.				below standpt.
			above standpt.				above standpt.
			below standpt.				below standpt.
			above standpt.				above standpt.
			below standpt.				below standpt.
			above standpt.				above standpt.
			below standpt.				below standpt.

Prepared by: *Ellis* 6/10/81  
 Checked: *Ellis* 15/8/81  
 Noted on U.T.M. Card *Ellis*

GS 24

STATION	BOND	1049
<p>Owner's Name: <b>NOT DETERMINED</b></p> <p>Address: .....</p> <p>Phone: .....</p>	<p>Current Occupant: .....</p> <p>Address: .....</p> <p>Phone: .....</p>	
<p><b>ACCESS</b></p>		
<p>Access Report of 17/9/1981 was found suitable/unsuitable.</p> <p><b>FEATURE</b></p> <p>KIA D.O</p> <p>3.64 PASS IRON GATE ON RIGHT</p> <p>3.68 TURN RIGHT THROUGH IRON GATE ~ WOOLSHED TO THE RIGHT.</p> <p>3.79 PASS THROUGH IRON GATE BETWEEN SHEDS ~ DRIVE TOWARDS TRIG.</p> <p>4.64 * BOND * TRIG.</p>		
<p><b>Record of Station</b></p>		
Date		

Beacon Diagram	Not to Scale
<p>CAIRN, POLE &amp; DISC IS RESPONSIBLE CONSTRUCTION.</p>	

<p>This section to be completed by officer constructing pillar.</p> <p>Original station mark found/not found.</p> <p>Description of mark: .....</p> <p>Original beacon found/not found.</p> <p>Description of beacon: .....</p> <p>Height Top of Vanes to Top Mark .....m.</p> <p>Height of mark: .....m. above rock/conc. ....m. below G.L.</p> <p>Diameter of Vanes .....m. Height of Cairn .....m.</p> <p>Original Beacon has/has not been destroyed by me.</p>	
--	--

GEODETTIC SURVEY OF N.S.W.

CENTRAL MAPPING AUTHORITY

GEODETTIC STATION RECONNAISSANCE AND MAINTENANCE REPORT

Description:

1. Cleared by lanes bearing..... See Station Diagram..... from Trig. Mast  
 Note: Cross out word or words which do not apply

2. Mast & Vanes have been painted white & black respectively. X.

3. The station/~~pillar~~ was ~~used~~/not uplied/~~concrete~~ on..... 7.0..... 19.34z, dimensions now being:  
 Cairn Mast

Description of mark..... See Station Diagram..... should be explicit, e.g., S/Steel Pillar Plate, Steel plug, Brass plug, Bolt, G.I. Pipe  
 Height of mark..... m. above rock/concrete; Mark is..... m. above G.L.

Height of Top Vanes to Top Mark/Pillar plate..... m. Diameter of Vanes (vertical)..... 62..... m.

Height of Cairn..... 4.2..... m. Diameter of Cairn..... 3.4..... m. Top Name Plate ~~found~~/not found/~~placed~~.

Length of Mast..... m. (approximate if not uplied)

4. G.I. P.P...... set in ~~concrete~~/Soil found, bearing..... 165..... °M from Mast/~~Plug/Pillar~~

5. A..... set in conc/rock has been placed/found, bearing..... °M from Mast/Plug/Pillar

6. A..... set in conc/rock has been placed/found, bearing..... °M from Mast/Plug/Pillar

7. A..... set in conc/rock has been placed/found, bearing..... °M from Mast/Plug/Pillar

8. Action required:.....

STANDPOINT:

STANDPOINT:

Mark	Direction	Horiz. Distance	Height Difference	Mark	Direction	Horiz. Distance	Height Difference
			above standpt				above standpt
			below				below
			above standpt				above standpt
			below				below
Prepared by: D. J. KAIN

Noted on U.T.M. Card

Checked:

Checked


STATION: BOND Geodetic Station No: 1049  
 MAP SHEETS SCALE: 1:250 000 CANBERRA. STAINWOOD  
 INSPECTED BY: D. J. KAIN DATE: 20.7.1984  
 AUTHORITY: C. M. A. FIELD BOOK: 1952

Station Diagram North Not to Scale

STATION IS SITUATED ON PROMINENT HILL AND IS CLEARED 360° CLOSE INTERVENING RIDGES BLOCK VISION LIMITING HORIZON. DISTANCE TO 10KMS. IN MOST DIRECTIONS. VISION IS ONLY POSSIBLE FROM 208° - 216°M, 282° - 290°M. MULLENGULLIEN RANGES? 15° - 23°M, 133 - 156M.

BOND  
 (Cairn Mast & Vanes)  
 IN FAIR CONDITION.  
 3.74m  
 16.2m  
 G.L.P.P.

STATION BOND GEODENIC STATION. 1049

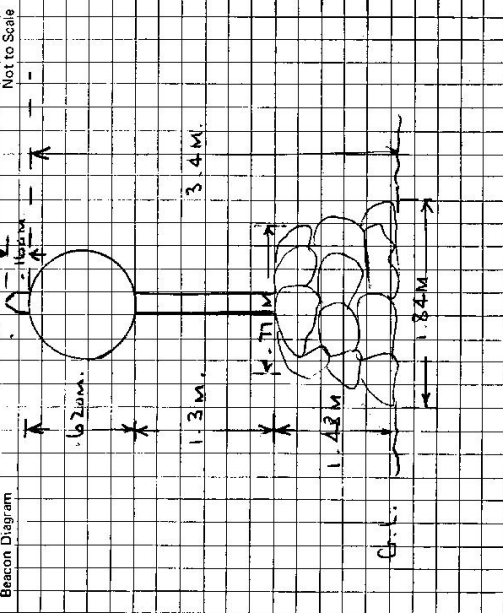

FREEHOLD  
 Owner's Name: CHITRA BRICK  
 Address: P.O. BOX 39  
PHUENHIEK VICTORIA 3056  
 Phone: .....

Current Occupant: .....

Address: .....

Phone: 20-7-1984

Access Report of 19/10/2019 was found suitable/unsuitable.  
 No Pravisa access.

Kms. 0.00

WIDELLAMA HALL AT SIGNS, OALLEN 21,  
NERZIGA 39, TUNEL TOWARD OALLEN,  
TURN LEFT 16 OALLEN 33 NERRIGA,  
PASS ENTRANCE TO QUARRIES ON YOUR LEFT AND RIGHT.  
TURN RIGHT THROUGH GATE OPENING.  
THROUGH GATE OPENING, YARDS/SHEARING SHED ON YOUR RIGHT.  
MAKE OWN WAY TO STATION ON YOUR LEFT.  
BOND GEODENIC STATION.

WEATHER ACCESS TO THIS STATION.

This section to be completed by officer constructing pillar.

Original station mark found/not found. ....

Description of mark: .....

Original beacon found/not found. ....

Description of beacon: .....

Height Top of Vanes to Top Mark: .....m.

Height of mark: .....m. above G.L. below G.L.

Diameter of Vanes .....m. Height of Cairn .....m.

Original Beacon has/has not been destroyed by me. ....

Date	Record of Station