

CENTRAL MAPPING AUTHORITY

GEODETIC SURVEY OF M.S.W.
 GEODETIC STATION RECONNAISSANCE and MAINTENANCE REPORT

STATION: **BONDI** No: **1050**

MAP SHEET SCALE 1:250 000
 INSPECTED BY: **P. NAYLOR** DATE: **13.7.77.**

AUTHORITY: **C.M.A.** FIELD BOOK:

Description:
 1. Cleared by lanes bearing.....
 Note: Cross out word or words which do not apply

2. Mast & Vanes have been painted white & black respectively.
 3. The station/pillar was ~~unplaced~~/not unplaced/~~constructed~~ on **13.7.77** dimensions now being:

Description of mark.....should be explicit, e.g., S/Steel Pillar Plate, Steel plug, Brass plug, Bolt, G.I. Pipe
 Height of mark.....m. ^{above} rock/concrete; Mark is.....m. ^{above} G.L.

Height of Top Vanes to Top Mark/Pillar plate.....m. Diameter of Vanes (vertical).....**2.2**.....m.
 Height of Cairn.....m. Diameter of Cairn.....**3.0**.....m. Name Plate found/not found/placed.

Length of Mast.....m. (approximate if not unplied)


4. A.....set in conc/rock has been placed/found, bearing.....° M from Mast/Plug/Pillar
 5. A.....set in conc/rock has been placed/found, bearing.....° M from Mast/Plug/Pillar
 6. A.....set in conc/rock has been placed/found, bearing.....° M from Mast/Plug/Pillar
 7. A.....set in conc/rock has been placed/found, bearing.....° M from Mast/Plug/Pillar

8. Action required:.....
 STATION **PRESENT** IS **SUITABLE FOR CONC. PILLAR**
BENCH IS IN POOR CONDITION.

STANDPOINT:

Mark	Direction	Horiz. Distance	Height Difference	Mark	Direction	Horiz. Distance	Height Difference
			above standpt.				above standpt.
			below standpt.				below standpt.
			above standpt.				above standpt.
			below standpt.				below standpt.
Prepared by: *[Signature]* 8.8.78 Checked: *[Signature]*
 Noted on U.T.M. Card

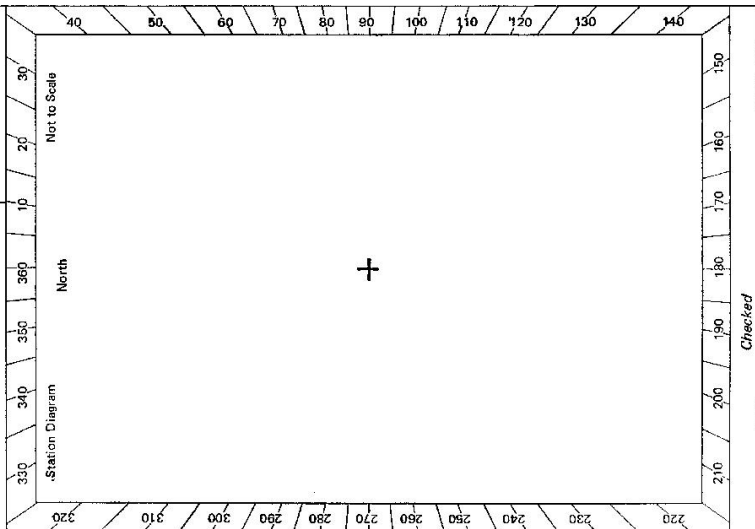

<p>St 2733-3 D. West, Government Printer</p>	<p>STATION</p>	<p>BONDI 1050</p>	<p>Owner's Name: W.P.C Address: LEETON PREVIOUSLY TRIG RESERVE Phone:</p> <p>Current Occupant: Geoffrey Mann (Lease) Address: Adjacency to the Bondi Reserve Phone: 62-3821</p> <p style="text-align: center;">ACCESS</p> <p>Access Report of 13.7.1972 was found suitable/unsuitable.</p> <p>Access from YARMANUI Crossing NARRANDERA 1:250 000 MAP REFERENCE 427/757</p>
<p>This section to be completed by officer constructing pillar.</p> <p>Original station mark found/not found.</p> <p>Description of mark:</p> <p>Original beacon found/not found.</p> <p>Description of beacon:</p> <p>Height Top of Vanes to Top Mark.....m.</p> <p>Height of mark.....m. above G.L. below G.L.</p> <p>Diameter of Vanesm. Height of Cairnm.</p> <p>Original Beacon has/not been destroyed by me.</p>			<p>Date</p> <p>Record of Station</p>

GEODETTIC SURVEY OF N.S.W.

CENTRAL MAPPING AUTHORITY


GEODETTIC STATION RECONNAISSANCE and MAINTENANCE REPORT

STATION: **BANDI GS** No.: **1050**

MAP SHEET SCALE 1:250 000

INSPECTED BY: **A. WOODRUFF** DATE: **15/07/18**

AUTHORITY: **CENTRAL MAPPING** FIELD BOOK: **1600**

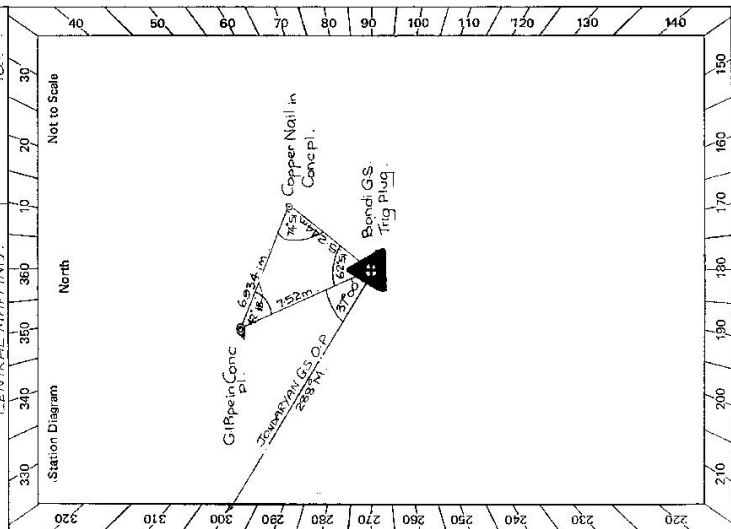

- Description:
- Note: Cross out word or words which do not apply*
- Cleared by lances bearing..... **313 M** → **55 M**..... **126 M**..... **225 M**..... from Trig. Mast
 - Mast & Vanes have been painted white & black respectively. ✓
 - The station/pillar was ~~unplaced~~/~~constructed on~~..... **19.78**....., dimensions now being: Description of mark..... **2.4**..... should be explicit, e.g., S/Steel Pillar Plate, Steel plug, Brass plug, Bolt, G.I. Pipe
 - Height of mark..... **0.075**.....m. ^{above} ~~below~~ rock/concrete; Mark is **0.075**.....m. ^{above} ~~below~~ G.L.
 - Height of Top Vanes to Top Mark/Pillar/Plate..... **2.4**.....m. Diameter of Vanes (vertical)..... **1.01**.....m.
 - Height of Cairn..... **1.8**.....m. Diameter of Cairn..... **1.2**.....m. Name Plate ~~found~~/~~not found~~/~~placed~~.
 - Length of Mast..... **3.67**.....m. (approximate if not unplied)
 - A..... **G.I. PIPE**..... set in conc/~~rock~~ has been placed/~~found~~; bearing..... **225**.....° M from Mast/Plug/Pillar
 - A..... **COPPER NAIL**..... set in conc/~~rock~~ has been placed/~~found~~; bearing..... **228**.....° M from Mast/Plug/Pillar
 - A..... set in conc/rock has been placed/~~found~~; bearing.....° M from Mast/Plug/Pillar
 - A..... set in conc/rock has been placed/~~found~~; bearing.....° M from Mast/Plug/Pillar
 - Action required:.....

STANDPOINT: **GIRPESIN Conc**

Mark	Direction	Horiz. Distance	Height Difference	Mark	Direction	Horiz. Distance	Height Difference
Copper Nail	93° 51'	5.244	0.16 ^{above} below standpt.	Copper Nail	174° 41'	6.934	0.075 ^{above} below standpt.
GIRPESIN	37° 00'	7.520	0.075 ^{above} below standpt.	BENDI GS Trig Plug	216° 59'	7.520	0.075 ^{above} below standpt.
BENDI GS	0° 00' 00"		0.075 ^{above} below standpt.	BENDI GS	0° 00' 00"		0.075 ^{above} below standpt.
			0.075 ^{above} below standpt.				0.075 ^{above} below standpt.
			0.075 ^{above} below standpt.				0.075 ^{above} below standpt.
			0.075 ^{above} below standpt.				0.075 ^{above} below standpt.
			0.075 ^{above} below standpt.				0.075 ^{above} below standpt.

Prepared by: **Alan Woodruff** Checked: **A. Woodruff** 30/3/19

Noted on U.T.M. Card

Sr: 2735-2 D. West, Government Printer

STATION **BONDI GS 1050**

Owner's Name: **W.B.G.**
 Address: **LEETON**
 Phone: **PREVIOUSLY TRIPOLI**

Current Occupant: **Gregory Mason Lessee**
 Address: **Adjoning Owner Mr. D. Fletcher**
 Phone: **20 SPIERSIST Griffith 67 3821**

ACCESS

Access Report of **19/19/18** was found suitable/unavailable.

0-00Kms. T intersection - Turn right to Leeton from Griffin. (Turn left to VENDA)

1-93 K Turn left onto gravel road - before Railway crossing.

4-01 K Pass through single iron gate.

4-98 K Turn left - pass through double iron gates into property Newgate.


5-70 K Pass through double iron gates over iron grid.

8-19 K Take main track veering right.

8-30 K Pass through single iron gate.

10-78 K Take truck to right.

11-33 Turn right off main track & make own way to crest of hill. Try is 70 metres walk from fence.

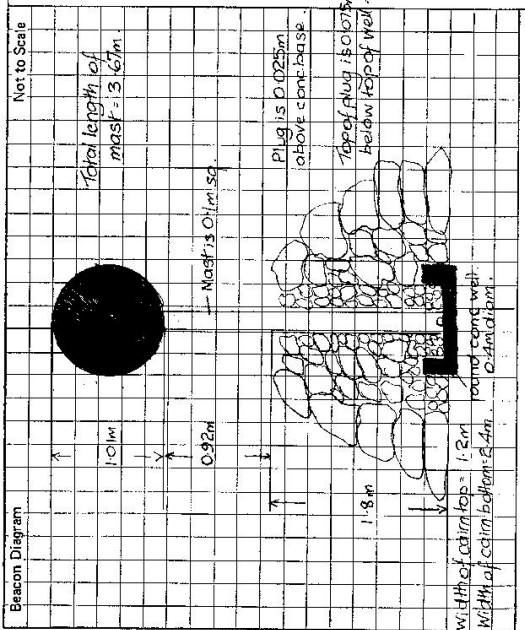

This section to be completed by officer constructing pillar.

Original station mark found/not found.

Description of mark: **Brass Trip Plug**

Original beacon found/not found.

Description of beacon: **Mast & vanes in poor condition**

Height Top of Vanes to Top Mark: **2.5m** approx

Height of mark: **0.025m** above G.L. / **0.025m** below G.L.

Diameter of Vanes: **0.012m** Height of Cairn: **1.2m**

Original Beacon has/has not been destroyed by me.

Date	Record of Station