


STATION TS PETTIT TS 10517

Owners Name:
 Current Occupant:

Address:
 Address:

Village of PETTITS
 Access 10.3.1976
 AT GANDAGAI PROCEED TOWARDS SYDNEY
 ON HUME HIGHWAY. TURN RIGHT AT
 NANANGROE TURN OFF (TRAFFIC ISLAND)
 AND FOLLOWED AS SKETCHED.

GOOD CONVENTIONAL
 VEHICULAR ACCESS

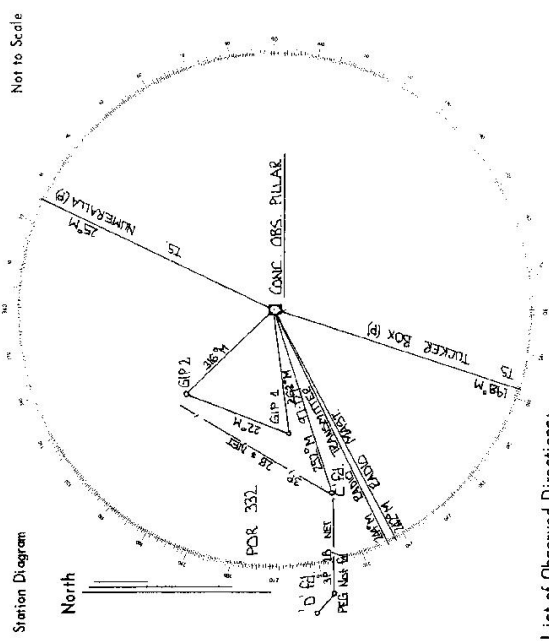

List of Observed Directions:-

Standpoint: CONC. PILLAR		Standpoint: G.P. 1	
Station	Direction	Station	Direction
TS NUMERALLA (P)	00° 00' 00"	TS NUMERALLA (P)	00° 00' 00"
TS TUCKERBOX (P)	172° 31' 44"	CONC. OBS. PILLAR	63° 15' 24"
G.P. 1	243° 11' 12"	TS TUCKERBOX (P)	172° 21' 54"
G.P. 2	290° 56' 31"	G.P. 2	359° 25' 58"

