


Co: CAMDEN Ph: CAMDEN
 Map Sheet: CAWDOOR 1: 10000 No: 6422
 Inspected by: L. M. HAYES Date: 2-3-78
 Authority: DEPT LANDS Field Book: 965

Beacon Diagram Not to Scale

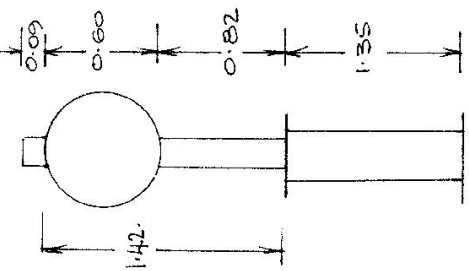

This Trig. Station has been: Note: Cross out word or words which do not apply

1. Completely cleared to permit 360° vision to surrounding Trigs.
2. Cleared by lones bearing from Trig. Mast
3. Trig. Mast & Vanes have been painted white & black respectively.
4. The Trig. was unpiled/~~not unpiled~~-dimensions now being:

Description of mark: ~~Rock~~ Beacon should be explicit, e.g. Steel plug, Brass plug, Bolt, Concrete Pillar
 Height of mark: ~~1.35~~ 1.35 m ^{above}/_{below} ~~concrete~~ concrete m above below G.L.
 Height of Top Vanes to Top Mark/Top pillar plate: 1.42 m Diameter of Vanes (vertical): 0.60 m.
 Height of Cairn: 1.35 m. Diameter of Cairn: m.
 Length of Mast: 1.51 m. (approximate if not unpiled)

5. ASM 1796A set in conc/~~rock~~ has been placed/fd 3.37 m, bearing 118 °M from Trig. Mast/pillar
6. A BT set in conc/~~soil~~ has been placed/fd 2.512 m, bearing 247 °M from Trig. Mast/pillar
7. A set in conc/~~soil~~ has been placed/fd m, bearing °M from Trig. Mast/pillar
8. A set in conc/~~rock~~ has been placed/fd m, bearing °M from Trig. Mast/pillar

9. Connection: SSM to BT 5.389 m, bearing 272 °M
10. Connection: to m, bearing °M
11. Connection: to m, bearing °M

12. Connection: to m, bearing °M
13. Diff. Ht. SSM 1796A is m. ^{above}/_{below} Pillar Plate
14. Diff. Ht. BT is m. ^{above}/_{below} Pillar Plate

15. Diff. Ht. is m. ^{above}/_{below}
16. Diff. Ht. is m. ^{above}/_{below}

Prepared by: L. M. HAYES Checked: C. STABLEY

Date	Record of Station
2-3-78	ERECTED.

