


STATION T.S. 10513 ERARING (P)
 Co: NORTHUMBERLAND Ph: COORUMBUNG
 Map Sheet: DORA CREEK No: 4535
 Inspected by: A. Graham Date: 7.7.1978
 Authority: INTEGRATION SURVEYS Field Book: PDP 661/11

Beacon Diagram Not to Scale

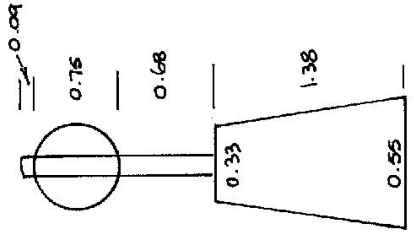

Date	Record of Station

Department of Lands
 Integral Survey of N.S.W.
 RECONNAISSANCE and MAINTENANCE REPORT

This Trig. Station has been:-
 Note: Cross out word or words which do not apply

1. ~~Completely cleared to permit 360° vision to surrounding terrain~~
2. Cleared by lanes bearing 321.1 M, 65° - 240° M from Trig. Mast
3. Trig. Mast & Vanes have been painted white & black respectively.
4. The Trig. ~~was unspiled/not unspiled~~, dimensions now being:

Description of mark: ~~Concrete~~ Pillar should be explicit, e.g. Steel plug, Brass plug, Bally Concrete Pillar
 Height of mark: 1.38 m ^{above} ~~below~~ rock/concrete base m ^{above} G.L.
 Height of Top Vanes to Top Mast/Top pillar plate 1.43 m Diameter of Vanes (vertical) 0.75 m.
 Height of Cairn m. Diameter of Cairn m.

- Length of Mast m. (approximate if not unspiled)
 SSM
 5. A. 24699 set in conc/rock has been placed at 4.997 m. bearing 117° M from Trig. Mast/pillar
 BRASS
 6. A. TRIANGLE set in conc/soil has been placed at 5.973 m. bearing 11 M from Trig. Mast/pillar
 7. A. set in conc/soil has been placed at m. bearing M from Trig. Mast/pillar
 8. A. set in conc/rock has been placed at m. bearing M from Trig. Mast/pillar
 SSM BRASS
 9. Connection: 24699 to TRIANGLE: 8.76 m. bearing 338° M
 10. Connection: to m. bearing M
 11. Connection: to m. bearing M
 12. Connection: to m. bearing M
 13. Diff. Ht. SSM 24699 is 1.63 m. ^{above} ~~below~~ Pillar Plate
 14. Diff. Ht. BRASS TRIANGLE is 1.46 m. ^{above} ~~below~~ Pillar Plate
 15. Diff. Ht. SSM 24699 is 0.17 m. ^{above} ~~below~~ BRASS TRIANGLE
 16. Diff. Ht. is m. ^{above} ~~below~~

Prepared by: Area 13. 11. 78 Checked: ca

CENTRAL MAPPING AUTHORITY

Department of Lands

Trigonometrical Survey of N.S.W.

RECONNAISSANCE & MAINTENANCE REPORT

This Trig. Station has been:-

Note: Cross out word or words which do not apply

1. Completely cleared to permit 360° vision to surrounding Trigs.
2. Cleared by lanes bearing..... from Trig. Mast
3. Trig. Mast & Vanes have been painted white & black respectively.
4. The Trig. was unpiled/not unpiled, dimensions now being:

Description of mark..... should be explicit, e.g. Steel plug, Brass plug, Bolt, G.I. Pipe

Height of mark..... m ^{above} / _{below} rock/concrete m ^{above} / _{below} G.L.
 Height of Top Vanes to Top Mark..... m. Diameter of Vanes (vertical)..... m.

Height of Cairn..... m. Diameter of Cairn..... m.

Length of Mast..... m. (approximate if not unpiled)

5. A..... set in conc/rock has been placed..... m. bearing..... °M from Trig. Mast
6. A..... set in conc/soil has been placed..... m. bearing..... °M from Trig. Mast
7. A..... set in conc/soil has been placed..... m. bearing..... °M from Trig. Mast
8. A..... set in conc/rock has been placed..... m. bearing..... °M from Trig. Mast

9. Connection..... to..... m. bearing..... °M

10. Connection..... to..... m. bearing..... °M

11. Connection..... to..... m. bearing..... °M

12. Connection..... to..... m. bearing..... °M

13. Diff. Ht. is..... m. ^{above} / _{below}

14. Diff. Ht. is..... m. ^{above} / _{below}

15. Diff. Ht. is..... m. ^{above} / _{below}

16. Diff. Ht. is..... m. ^{above} / _{below}

Prepared by: P. O'Keefe

Checked:

Noted on U.T.M. Card

Checked

STATION TS 10523 ERARING

Co. Northumberland Ph: Courumbung


Map Sheet: Dora Creek No: 04535

Inspected by: P. O'Keefe Date: 16/11/89

Authority: SCB, Newcastle

Beecon Diagram

Not to Scale

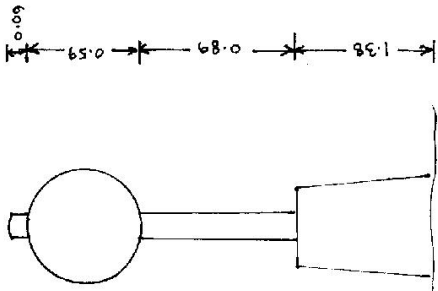

Date	Record of Station
11/11/89	Replaced Mast & Vanes

