


7.19.3

STATION TS ANVIL PILLAR 10525
 Co: Brisbane Ph: WYBONGI
 Map Sheet: 9033 Muswellbrook No: 9033
 Inspected by: P. McBeath Date: 6.3.78
 Authority: ISD NCLB Field Book: 98681

Beacon Diagram
 Not to Scale
 0.09
 0.60
 0.865
 1.24

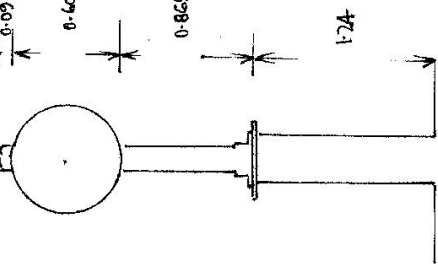

Date	Record of Station
March 78	Pillar Erected

Department of Lands
 Integrating Survey of N.S.W.
 RECONNAISSANCE and MAINTENANCE REPORT

This Trig. Station has been: Note: Cross out word or words which do not apply

- 1. Completely cleared to permit 360° vision to surrounding Trigs. ✓
- 2. Cleared by lanes-bearing from Trig. Mast

3. Trig. Mast & Vanes have been painted white & black respectively. ✓
 4. The Trig. was unpiled/not unpiled, dimensions now being:

Description of mark: steel pillar should be explicit, e.g. Steel plug, Brass plug, Bolt, Concrete Pillar
 Height of mark: 1.24 m above rock/concrete 1.24 m above G.L.
 Height of Top Vanes to Top-Mark/Top pillar plate: 1.465 m Diameter of Vanes (vertical) 0.60 m.
 Height of Cairn: 1.24 m Diameter of Cairn: 1.25 m.

Length of Mast: 1.555 m. (approximate if not unpiled)
 5. A SSM 2.4721 set in conc/rock has been placed/d 4.840 m. bearing 180° from Trig. Mast/pillar
 6. A Copper Splice set in conc/soil has been placed/d 4.926 m. bearing 270° from Trig. Mast/pillar
 7. A set in conc/soil has been placed/d m. bearing °M from Trig. Mast/pillar
 8. A set in conc/rock has been placed/d m. bearing °M from Trig. Mast/pillar

9. Connection SSM to C.S. 7.106 m. bearing 136° °M
 10. Connection to m. bearing °M
 11. Connection to m. bearing °M

12. Connection to m. bearing °M
 13. Diff. Ht. SSM 2.4721 is 1.595 m. above pillar plate
 14. Diff. Ht. Copper Splice is 1.396 m. above pillar plate
 15. Diff. Ht. SSM 2.4721 is 0.203 m. above copper splice
 16. Diff. Ht. is m. above

Prepared by PAF Checked: CC

STATION TS10525 ANVIL PILLAR

Owners Name..... Current Occupant.....

Address..... Address.....

- Access 6.3.78
At Musselthorpe - Follow Sandy Hollow Road for 18 Km.
0.0 Turn of Castle Rock Rd and Sandy Hollow to Musselthorpe Rd.
Travel west.
0.2 Take left fork - Sign "Sandy Hollow 20"
4.8 Pass road on R.H.S - Sign "Whitson Hall 5"
4.9 Turn left into Iron Gate on L.H.S - tracks comes to right hand side of house being renovated.
5.0 Iron Gate - old shed on R.H.S.
5.05 Slip rails
5.1 Creek crossing - (sandy) - follow Track
5.4 Slip rails
6.2 Old fence - follow over.
6.3 Creek crossing.
6.9 opening in fence
7.4 Slip rails
7.6 Fence on L.H.S
7.85 Leave track to right just before set of slip rails
7.9 Leave vehicle at bogged tree.
Walk up ridge to top of hill and Trig.
20 min climb through rocks with load.
4 wheel drive access.

