

TS 10527

Department of Lands
 Integrative survey of N.S.W.
 RECONNAISSANCE and MAINTENANCE REPORT

STATION TS 10527 Holly Dell (P)

This Trig. Station has been:-

Co: Trisbane Ph: XXXXXXXXXX

1. Completely cleared to permit 360° vision to surrounding Trigs. ✓

2. Cleared by lenses-bearing from Trig. West

3. Trig. Mast & Vanes have been painted white & black respectively. ✓

4. The Trig. was unpiled/~~not unpiled~~, dimensions now being:

Description of mark steel pillar should be explicit, e.g. Steel plug, Brass plug, Bolt, Concrete Pillar

Height of mark 1.3 m above rock/concrete 0.6 m above G.L.

Height of Top Vanes to ~~Top~~/Top pillar plate 1.47 m Diameter of Vanes (vertical) 0.6 m.

Height of Cairn 1.3 m. Diameter of Cairn 0.12 x 0.39 m.

Length of Mast 1.56 m. (approximate if not unpiled)

5. A SSM 24694 set in conc./~~rock~~ has been placed/d 4.038 m. bearing 172°M from Trig. Mast/pillar

6. A Copper Spike set in conc./~~soil~~ has been placed/d 3.859 m. bearing 90°M from Trig. Mast/pillar

7. A _____ set in conc./soil has been placed/d _____ m. bearing _____°M from Trig. Mast/pillar

8. A _____ set in conc./rock has been placed/d _____ m. bearing _____°M from Trig. Mast/pillar

9. Connection SSM to CS : 5.146 m. bearing 39°M

10. Connection _____ to _____ : _____ m. bearing _____°M

11. Connection _____ to _____ : _____ m. bearing _____°M

12. Connection _____ to _____ : _____ m. bearing _____°M

13. Diff. Ht. Pillar Plate is 1.194 m. above SSM 24694

14. Diff. Ht. Pillar Plate is 1.329 m. above CS

15. Diff. Ht. SSM 24694 is 0.134 m. above CS

16. Diff. Ht. _____ is _____ m. above _____

Prepared by CC Checked: CC

Map Sheet: Muswellbrook

Inspected by: A. Richardson


Authority: ISD NOLA

No: 9033

Date: 6.3.78

Field Book: 680 FDP

Beacon Diagram

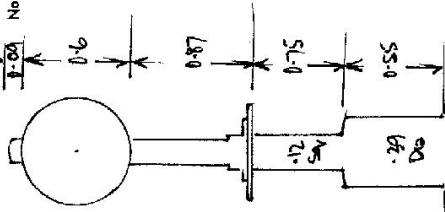

Date	Record of Station
6/3/78	Pillar Erected

STATION TS 10527 HOLLYDEEN(P)

Current Occupant.....

Address.....


Owners Name.....

Address.....

Access 6-3-1978

N.O. Iken Derrnan - Sands Hollow Rd and Wybong Rd at Hollydeen - (near Wybong Ck causeway)
 Travel towards Sandy Hollow.
 Leave vehicle at top of hill in saddle.
 Trig is on top of hill on Sth side of road.
 Walk up hill under transmission line and to top of hill.

200m 20min with load.

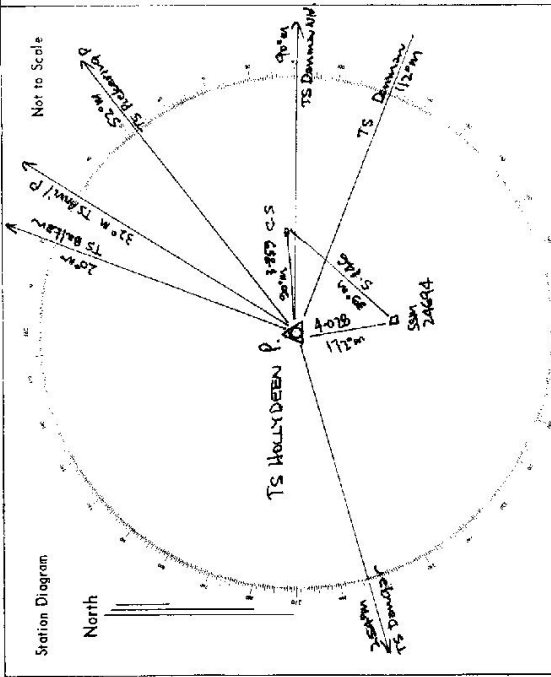

List of Observed Directions:-

Standpoint: TS Hollydeen P		Standpoint: SSM 24694	
Station	Direction	Station	Direction
TS Danger	0° 00' 00"	TS Damman	0° 00' 00"
TS Bollean	126° 58' 50.58"	TS Hollydeen P	78° 03' 28"
TS Annell P	138° 19' 31.93"	Copper Spike	146° 54' 33"
TS Packerina P	158° 24' 48.19"		
Copper Spike	196° 34' 28.5"		

Station	Direction	Station	Direction
TS Damman Nth	96° 40' 08.78"		
TS Damman	218° 02' 07.58"		
SSM 24694	270° 05' 24"		