





LAND INFORMATION CENTRE

GEODETIC SURVEY OF A.S.M.

GEODETIC STATION RECONNAISSANCE and MAINTENANCE REPORT

STATION: **BOMEN T.S.** No.: **10531**

MAP SHEET SCALE 1:250 000

INSPECTED BY: **R. LANDER** DATE: **3-2-92**

AUTHORITY: **CALM** FIELD BOOK:

Description: **360°** Note: Cross out word or words which do not apply

1. Cleared by vanes bearing..... from Trig. Mast

2. Mast & Vanes have been painted white & black respectively.

3. The station/pillar was unpiled/not unpiled/constructed on..... 19....., dimensions now being:

Description of mark..... **S.S. PILLAR MARK**ould be explicit, e.g., S/Steel Pillar Plate, Steel plug, Brass plug, Bolt, G.I. Pipe

Height of mark.....m. above below concrete; Mark is.....m. above G.L. below

Height of Top Vanes to Top Mark/Pillar plate **1.45**.....m. Diameter of Vanes (vertical) **0.75**.....m.

Height of Cairn.....m. Diameter of Cairn.....m. Name Plate found/net-found/pileed.

Length of Mast.....m. (approximate if not unpiled)

4. A.....set in conc/rock has been placed/found, bearing.....°M from Mast/Plug/Pillar

5. A.....set in conc/rock has been placed/found, bearing.....°M from Mast/Plug/Pillar


6. A.....set in conc/rock has been placed/found, bearing.....°M from Mast/Plug/Pillar

7. A.....set in conc/rock has been placed/found, bearing.....°M from Mast/Plug/Pillar

8. Action required:.....

STANDPOINT:		STANDPOINT:					
Mark	Direction	Horiz. Distance	Height Difference	Mark	Direction	Horiz. Distance	Height Difference
			above standpt. below				above standpt. below
			above standpt. below				above standpt. below
Prepared by: **R. LANDER.** Checked: **Noted on U.T.M. Card**

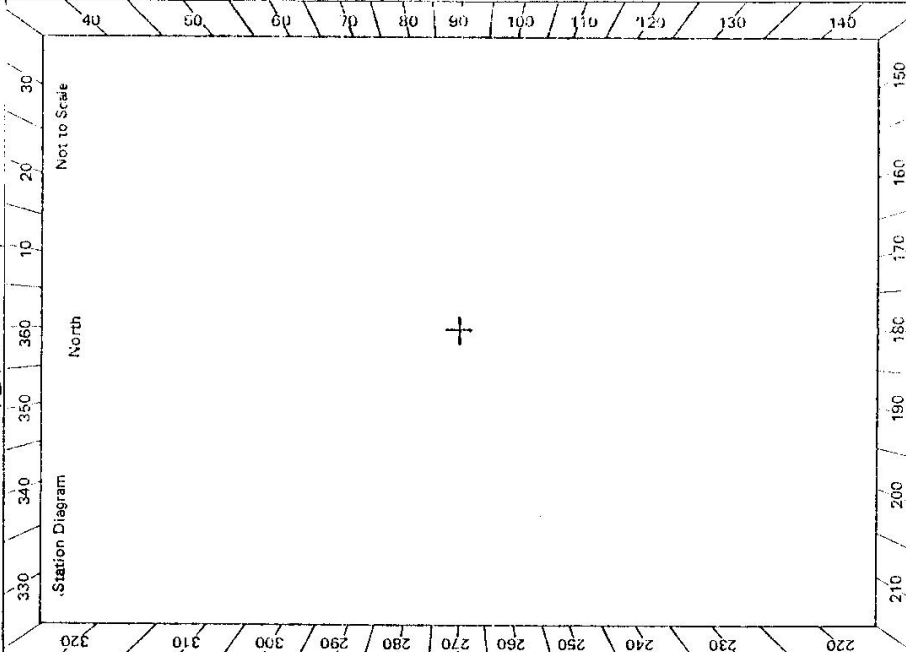

STATION **BOMEN T.S. 10531**

Owner's Name: .....  
 Address: .....  
 Phone: .....  
 Current Occupant: .....  
 Address: .....  
 Phone: .....

ACCESS  
 Access Report of **3.2.19.92** was found suitable/unsuitable.

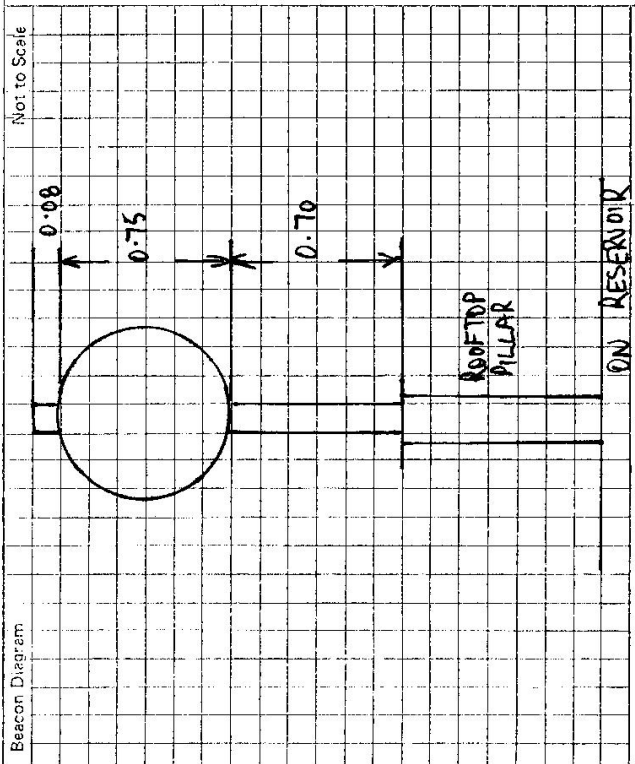

This section to be completed by officer constructing pillar.

Original station mark found/not found.

Description of mark: .....

Original beacon found/not found.

Description of beacon: .....

Height Top of Vanes to Top Mark.....m.

Height of mark.....m. above rock/conc.....m. below G.L.

Diameter of Vanes .....m. Height of Cairn .....m.

Original Beacon has/not been destroyed by me.

Date Record of Station

**3-2-92 NEW MAST & VANES PLACED**