



STATION TS 10535 : NORTH ROTHBURY


Current Occupant.....

Address.....

Owners Name: H.D.M.P.

Address.....


Dec 1977  
 Access See GRETA 1:25000 map  
 KEY B. Permission to occupy T.S. must be obtained from  
 H.D.M.P. (Survey Section)  
 NEW ENGLAND HIGHWAY  
 500m  
 BRANKTON  
 PHAIN  
 NORTHERN LINE

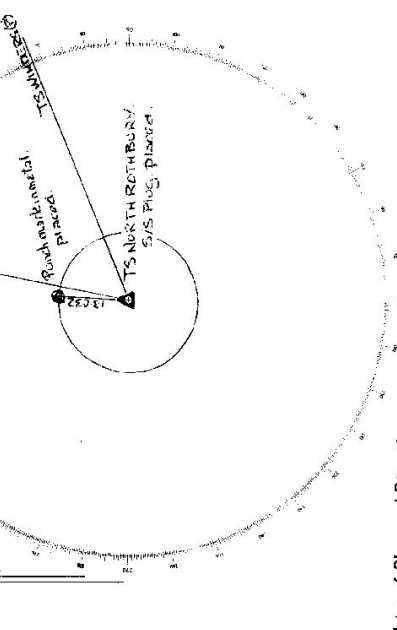

List of Observed Directions:-

Standpoint: S/S Plus

Station	Direction	Station	Direction
STANNOR T.S.	23° 31' 49" S		
WINDERS (P) T.S.	82° 15' 55" S		
PLAUMARK DISED	15° 24' 17"		
Station	Direction	Station	Direction

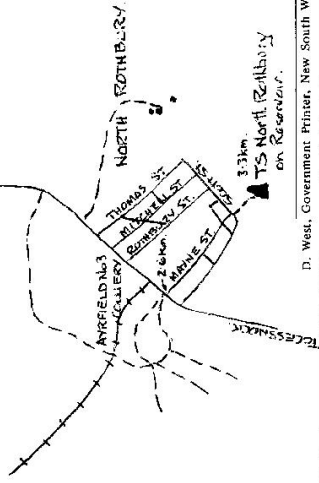

D. West, Government Printer, New South Wales - 1976