

7.4.98

Trigonometric Survey of N.S.W.

RECONNAISSANCE & MAINTENANCE REPORT

STATION **BUSHELL S PILLAR TS 10537**

Co: **CAMDEN** Pht: **KEMBLA**

Map Sheet: **WOLLONGONG** No: **9029-II-S**

Inspected by: \_\_\_\_\_ Date: \_\_\_\_\_

Authority: **S.M.E.C.** Field Book: \_\_\_\_\_

Beacon Diagram **0.1** Not to Scale

G.L.

1.48

1.38

0.60

Record of Station  
Pillar erected on 22-11-77 by B.H.P.

---

Prepared by: **B.H.P. SURVEY DEPT.** Checked: \_\_\_\_\_

Noted on U.T.M. Card

This Trig. Station has been:-

1. Completely cleared to permit 360° vision to surrounding Trigs.
2. ~~Clearance by stone-bearing~~ ..... from Trig. Mast
3. Trig. Mast & Vanes have been painted white ~~black respectively~~
4. The Trig. was unpiled/not unpiled, dimensions now being:
  - Description of mark **Concrete Pillar** ..... should be explicit, e.g. Steel plug, Brass plug, Bolt, G.I. Pipe
  - Height of mark ..... m <sup>above</sup> ~~below~~ **rock/concrete** ..... m <sup>above</sup> ~~below~~ **G.L.**
  - Height of Top Vanes to Top Mark **1.48** m. Diameter of Vanes (vertical) **0.60** m.
  - Height of ~~Cable~~ ..... m. Diameter of ~~Cable~~ ..... m.
  - Length of Mast ..... m. (approximate if not unpiled)

5. A ..... set in conc/rock has been placed ..... m. bearing ..... °M from Trig. Mast
6. A ..... set in conc/soil has been placed ..... m. bearing ..... °M from Trig. Mast
7. A ..... set in conc/soil has been placed ..... m. bearing ..... °M from Trig. Mast
8. A ..... set in conc/rock has been placed ..... m. bearing ..... °M from Trig. Mast
9. Connection ..... to ..... m. bearing ..... °M
10. Connection ..... to ..... m. bearing ..... °M
11. Connection ..... to ..... m. bearing ..... °M
12. Connection ..... to ..... m. bearing ..... °M
13. Diff. Ht. .... is ..... m. <sup>above</sup> ~~below~~
14. Diff. Ht. .... is ..... m. <sup>above</sup> ~~below~~
15. Diff. Ht. .... is ..... m. <sup>above</sup> ~~below~~
16. Diff. Ht. .... is ..... m. <sup>above</sup> ~~below~~

STATION **BUSHELLS** (MILLAR) T.S. 10537


Owners Name **A. I. & S.** Current Occupant.....

Address **P.O. WOLLONGONG** Address.....

Access.....

Not to Scale


Station Diagram

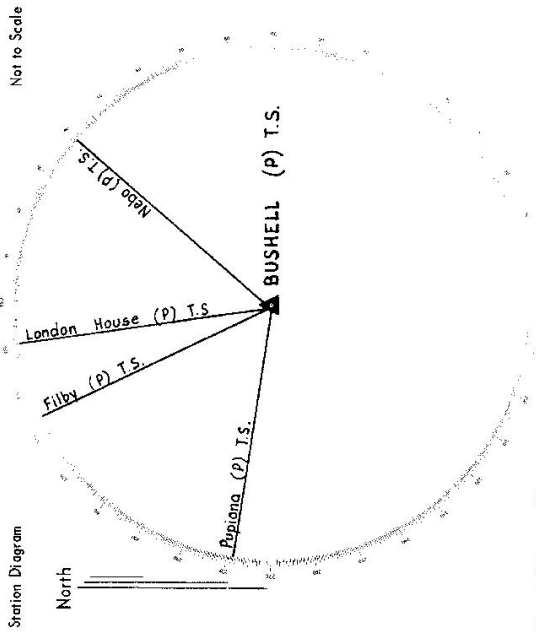

List of Observed Directions:-

Station	Direction	Station	Direction
Pupiana Pillar	359° 59' 60"		
Filby Pillar	60° 06' 10"		
London House Pillar	77° 42' 05"		
Nebo Pillar	130° 51' 27"		
Station	Direction	Station	Direction

LOCALITY SKETCH

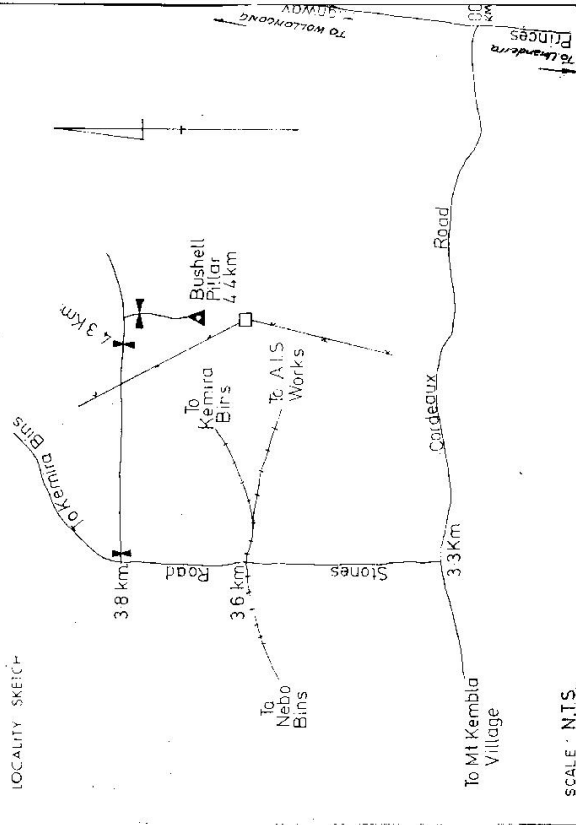

SCALE: N.T.S.

BT 2733-3 D. West. Government Printer

Beacon Diagram		Not to Scale
<p>This section to be completed by officer constructing pillar.</p> <p>Original station mark found/not found: .....</p> <p>Description of mark: .....</p> <p>Original beacon found/not found: .....</p> <p>Description of beacon: .....</p> <p>Height Top of Vanes to Top Mark: .....m.</p> <p>Height of mark: .....m. above rock/conc. ....m. below G.L.</p> <p>Diameter of Vanes .....m. Height of Cairn .....m.</p> <p>Original Beacon has/has not been destroyed by me.</p>		

STATION **BUSHELLS (P)** 10537

Owner's Name: **MRS JANET & BEN MEDINA**  
 Address: **MT KEMBLA VILLAGE DOG BOARDING KENNELS**  
 Phone: **02 42 39 6408**  
**MOBILE 04 07 00 9930**  
 Access Report of: ...../B.....was found suitable/unsuitable.  
 Current Occupant: .....  
 Address: .....  
 Phone: .....

July 2000

- 10537 Bushells (P)
- 0.00 At MT Kembra Hotel travel towards Wollongong
  - 0.3 Turn left into Stones road
  - 0.55 Bridge straight ahead
  - 0.8 Turn right across grid sign "Bartholomew" follow straight ahead Gate sign " MT Kembra Village Dog Boarding Kennels "
  - 1.2 (Strictly no admittance without appointment) Bushells pillar 100 metres to south of gateways near power lines

Date		INSPECTED BY: <b>G. FORD</b>	DATE: <b>17-7-00</b>
	Record of Station		
	<b>Good GPS</b>		
	<b>ACCESS ONLY</b>		