




STATION PUPIANA (P) T.S. 10538

Owners Name... A. I. S. S. Current Occupant.....

Address... P.O. WOLLONGONG Address.....

Access

Station Diagram Not to Scale

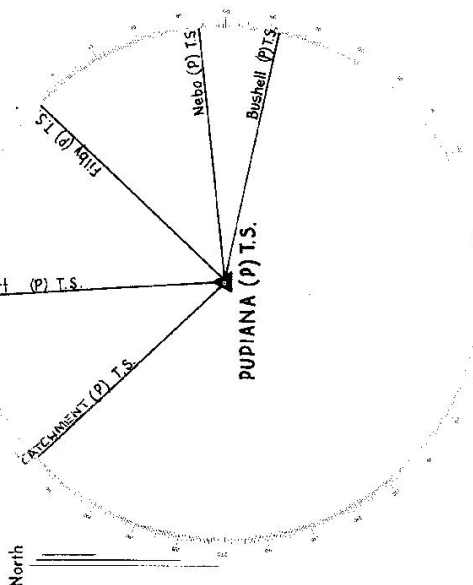

List of Observed Directions:-

Station	Direction	Station	Direction
CATCHMENT Pillar	359° 59' 60"		
Hurl Pillar	40° 36' 05"		
Filby Pillar	85° 11' 46"		
Nebo Pillar	125° 27' 10"		
Bushell Pillar	142° 10' 02"		
Station	Direction	Station	Direction

