

CENTRAL MAPPING AUTHORITY
Department of Lands

Trigonometrical Survey of N.S.W.

RECONNAISSANCE and MAINTENANCE REPORT

STATION **FILBY (P) T.S. 10539**

This Trig. Station has been:-

Note: Cross out word or words which do not apply

1. ~~Completely cleared to permit 360° vision to surrounding lands~~
2. Cleared by lanes bearing as per station diagram from Trig. Mast
3. Trig. Mast & Vanes have been painted white ~~at least respectively~~
4. The Trig. was unpiled/not unpiled, dimensions now being: ~~_____~~
Description of mark Concrete Pillar should be explicit, e.g. Steel plug, Brass plug, Ball, G.I. Pipe
Height of mark 1.38 m above rock/concrete ~~_____~~ m above G.L.
Height of Top Vanes to Top Mark 1.48 m. Diameter of Vanes (vertical) 0.60 m.
Height of ~~Cabin~~ _____ m. Diameter of ~~Cabin~~ _____ m.

Length of Mast _____ m. (approximate if not unpiled)

5. A _____ set in conc/rock has been placed _____ m. bearing _____ °M from Trig. Mast
6. A _____ set in conc/soil has been placed _____ m. bearing _____ °M from Trig. Mast
7. A _____ set in conc/soil has been placed _____ m. bearing _____ °M from Trig. Mast
8. A _____ set in conc/rock has been placed _____ m. bearing _____ °M from Trig. Mast

9. Connection _____ to _____ m. bearing _____ °M

10. Connection _____ to _____ m. bearing _____ °M

11. Connection _____ to _____ m. bearing _____ °M

12. Connection _____ to _____ m. bearing _____ °M

13. Diff. Ht. _____ is _____ m. ^{above}/_{below}

14. Diff. Ht. _____ is _____ m. ^{above}/_{below}

15. Diff. Ht. _____ is _____ m. ^{above}/_{below}

16. Diff. Ht. _____ is _____ m. ^{above}/_{below}

Prepared by: B.R.P. SURVEY DEPT.

Noted on U.T.M. Card

Checked

Co: **CAMDEN** Ph: **KEMBLA** No: **9029-II-S**
Map Sheet: **WOLLONGONG** Date: _____
Inspected by: _____ Field Book: _____


Authority: **S.M.E.C.**

Bacon Diagram **0.1** Net to Scale

0.60

0.88

1.38

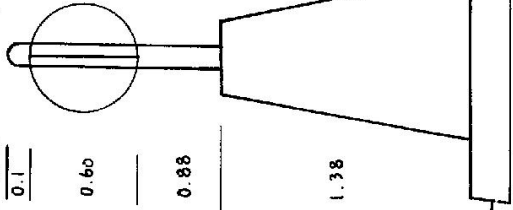

Record of Station

Date Pillar erected on 22-11-77 by B.R.P.

Date	


STATION **FILBY (P)** T.S. **10539**

Owners Name **A. J. S.** Current Occupant

Address **P.O. WOLLONGONG** Address


Access

LOCALITY SKETCH

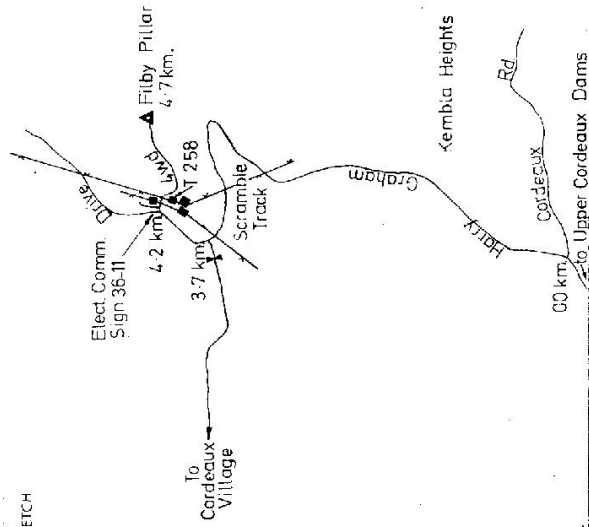

SCALE N.T.S.

Station Diagram Net to Scale

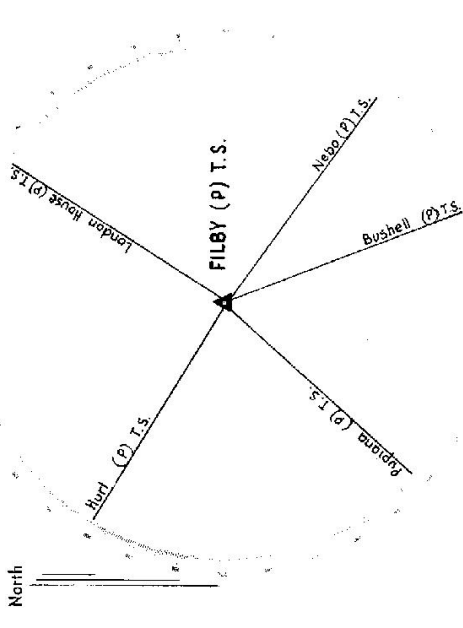

List of Observed Directions:

Standpoint: Pillar		Station	Direction
London House Pillar	359° 59' 60"		
Nebo Pillar	93° 21' 42"		
Bushell Pillar	126° 52' 11"		
Poppuna Pillar	189° 41' 59"		
Hurt Pillar	269° 25' 21"		
Station	Direction	Station	Direction