

CENTRAL MAPPING AUTHORITY  
Department of Lands

Trigonometrical Survey of N.S.W.

RECONNAISSANCE and MAINTENANCE REPORT

This Trig. Station has been:-

Note: Cross out word or words which do not apply

1. ~~Completely cleared to permit 360° vision to surrounding trig.~~
2. Cleared by lanes bearing as per station diagram from Trig. Mast
3. Trig. Mast & Vanes have been painted white ~~black~~
4. The Trig. was unpiled/not unpiled, dimensions now being:
  - Description of mark Concrete Pillar should be explicit, e.g. Steel plug, Brass plug, Bolt, G.I. Pipe
  - Height of mark 1.38 m above ~~stone~~ rock/concrete ~~stone~~ m above ~~stone~~ 6-6
  - Height of Top Vanes to Top Mark 1.48 m. Diameter of Vanes (vertical) 0.60 m.
  - ~~Height of Cairn~~ m. ~~Diameter of Cairn~~ m.
  - ~~Length of Mast~~ m. (approximate if not unpiled)
5. A..... set in conc/rock has been placed..... m. bearing..... °M from Trig. Mast
6. A..... set in conc/soil has been placed..... m. bearing..... °M from Trig. Mast
7. A..... set in conc/soil has been placed..... m. bearing..... °M from Trig. Mast
8. A..... set in conc/rock has been placed..... m. bearing..... °M from Trig. Mast
9. Connection..... to..... m. bearing..... °M
10. Connection..... to..... m. bearing..... °M
11. Connection..... to..... m. bearing..... °M
12. Connection..... to..... m. bearing..... °M
13. Diff. Ht. .... is..... m. <sup>above</sup>/<sub>below</sub>
14. Diff. Ht. .... is..... m. <sup>above</sup>/<sub>below</sub>
15. Diff. Ht. .... is..... m. <sup>above</sup>/<sub>below</sub>
16. Diff. Ht. .... is..... m. <sup>above</sup>/<sub>below</sub>

Prepared by: B.H.P. SURVEY DEPT. Checked: Checked

Noted on U.T.M. Card

HOUSE

STATION LONDON H. 5E (P) I.S. 10540


Co: CAMDEN Pht: KEMBLA

Map Sheet: WOLLONGONG No: 9029- II - S

Inspected by: \_\_\_\_\_ Date: \_\_\_\_\_

Authority: S.M.E.C. Field Book: \_\_\_\_\_

Beacon Diagram 0.1 Net to Scale

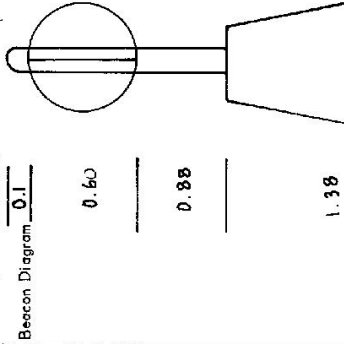

Date \_\_\_\_\_ Record of Station

ROCK  
Pillar erected on 24-11-77 by B.H.P.

Checked

STATION **LONDON HOUSE (P) 10540 T.S.**  
(10540)

Owners Name... **A. I. & S.**


Address... **P.O. WALLONGONG**

Current Occupant.....

Address.....


Access

Station Diagram

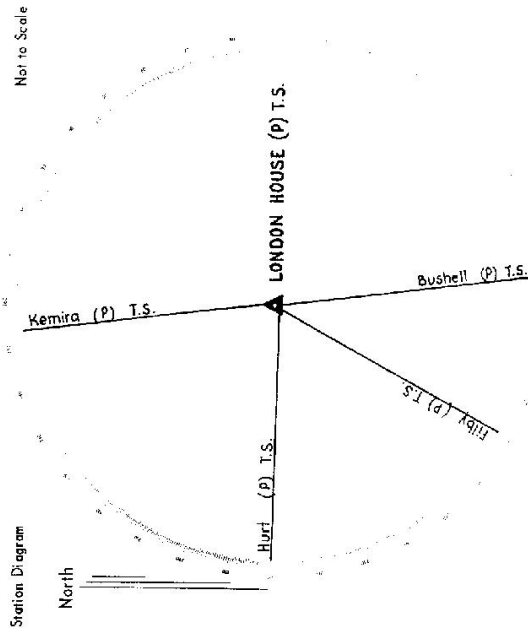

List of Observed Directions:-

Station	Direction	Station	Direction
Bushell Pillar	359° 59' 60"	Hurst Pillar	95° 31' 57"
Filby Pillar	94° 27' 24"	Kemira Pillar	179° 42' 36"

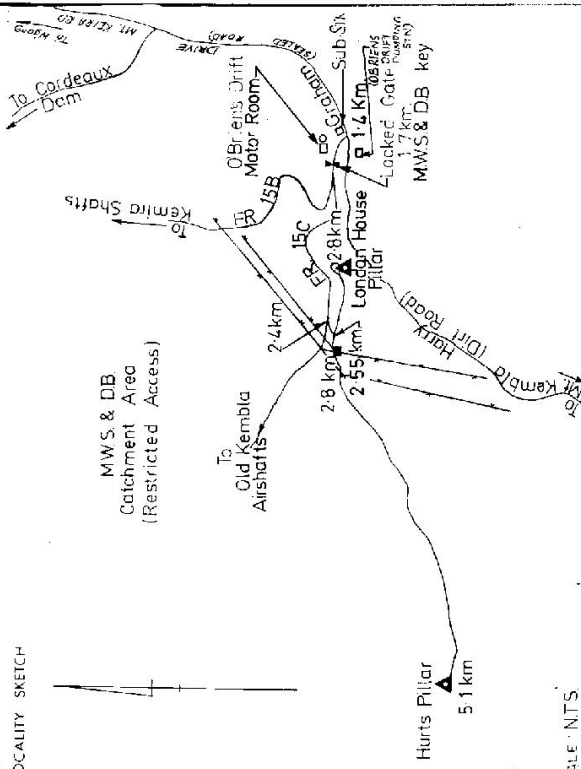

SCALE N.T.S.