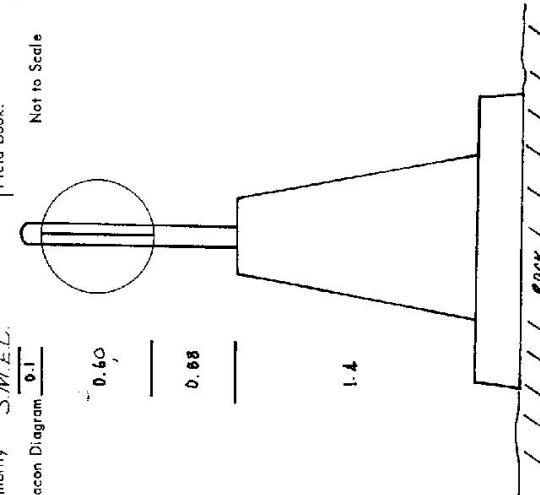


CENTRAL MAPPING AUTHORITY Department of Lands	Trigonometrical Survey of N.S.W. RECONNAISSANCE and MAINTENANCE REPORT	STATION CATCHMENT(P) <b>T.S. 10541</b> Co: <b>CAMDEN</b>   Pht: <b>KEMBLA</b> Map Sheet: <b>WOLLONGONG</b>   No: <b>9029 - II - S</b> Inspected by: _____ Date: _____ Authority: <b>S.M.E.C.</b>   Field Book: _____ Beacon Diagram $\frac{0.1}{0.1}$   Not to Scale
This Trig. Station has been:- Note: Cross out word or words which do not apply		
1. <del>Completely cleared to permit 360° vision to surrounding Trips.</del> 2. Cleared by lanes bearing <u>95°</u> per station diagram from Trig. Mast 3. Trig. Mast & Vanes have been painted white & black respectively. 4. The Trig. was unpiled/not unpiled, dimensions now being: _____ Description of mark: <u>Concrete Pillar</u> should be explicit, e.g. Steel plug, Brass plug, Bolt, G.I. Pipe Height of mark: <u>1.4</u> m above <del>rock</del> / <u>concrete</u> <del>to</del> <u>above</u> <del>to</del> <u>G.L.</u> Height of Top Vanes to Top Mark: _____ m. Diameter of Vanes (vertical) <u>0.60</u> m. Height of <del>Cable</del> _____ m. Diameter of <del>Cable</del> _____ m. Length of Mast _____ m. (approximate if not unpiled)	5. A. _____ set in conc/rock has been placed _____ m. bearing _____ °M from Trig. Mast 6. A. _____ set in conc/soil has been placed _____ m. bearing _____ °M from Trig. Mast 7. A. _____ set in conc/soil has been placed _____ m. bearing _____ °M from Trig. Mast 8. A. _____ set in conc/rock has been placed _____ m. bearing _____ °M from Trig. Mast 9. Connection _____ to _____ m. bearing _____ °M 10. Connection _____ to _____ m. bearing _____ °M 11. Connection _____ to _____ m. bearing _____ °M 12. Connection _____ to _____ m. bearing _____ °M 13. Diff. Ht. _____ is _____ m. <sup>above</sup> / <sub>below</sub> 14. Diff. Ht. _____ is _____ m. <sup>above</sup> / <sub>below</sub> 15. Diff. Ht. _____ is _____ m. <sup>above</sup> / <sub>below</sub> 16. Diff. Ht. _____ is _____ m. <sup>above</sup> / <sub>below</sub>	
Prepared by: <b>B.H.P. SURVEY DEPT.</b>		Date: _____ Record of Station Pillar erected on 5-12-77 by B.H.P.
Checked: _____		Checked: _____
Noted on U.T.M. Card		

STATION CATCHMENT (P) T.S. 10541

Current Occupant.....

Address.....


Owners Name... M.W.S. & D.B.

Address... SYDNEY

Access.....


Not to Scale

Station Diagram

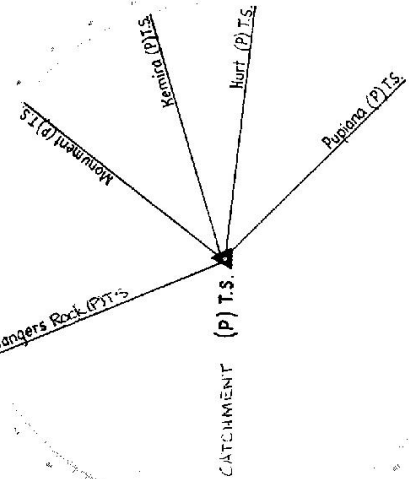

List of Observed Directions:-

Station	Direction	Station	Direction
Hangers Rock (P) T.S.	359° 59' 60"		
Monument Pillar	61° 57' 16"		
Kemira Pillar	97° 17' 57"		
Hurt Pillar	120° 49' 36"		
Pupiana Pillar	158° 52' 57"		
Station	Direction	Station	Direction

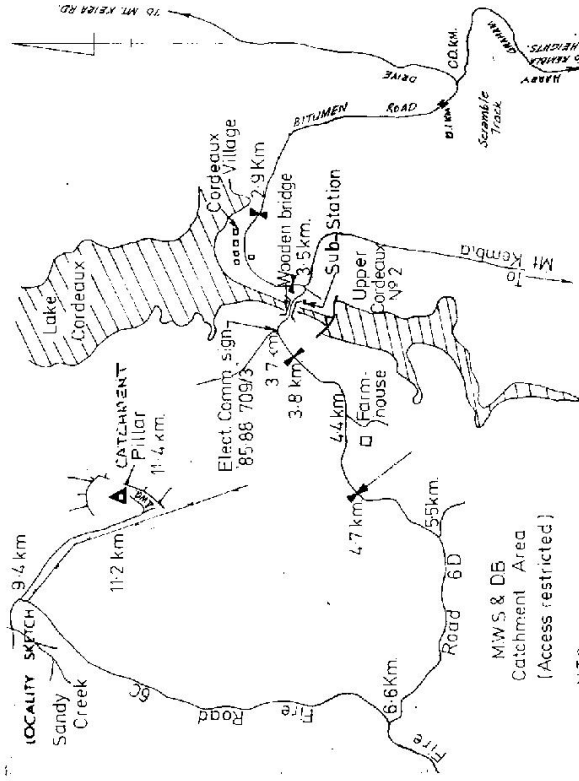

M.W.S & D.B  
Catchment Area  
(Access restricted)

SCALE NTS