

CENTRAL MAPPING AUTHORITY
Department of Lands


Trigonometrical Survey of N.S.W.

RECONNAISSANCE and MAINTENANCE REPORT

STATION **HURT'S (P)** / T.S. **10542**

This Trig. Station has been:-


Note: Cross out word or words which do not apply

1. ~~Completely cleared to permit 360° vision to surrounding objects~~
2. Cleared by lances bearing 05 per station diagram from Trig. Mast
3. Trig. Mast & Vanes have been painted white & black respectively.
4. The Trig. was unpiled/not unpiled, dimensions now being:  should be explicit, e.g. Steel plug, Brass plug, Bolt, G.I. Pipe

- Description of mark Concrete Pillar
- Height of mark 1.38 m above rock/concrete 6 in.
- Height of Top Vanes to Top Mark 1.48 m. Diameter of Vanes (vertical) 0.60 m.
- ~~Height of Core~~ m. ~~Diameter of Core~~ m.
- ~~Length of Mast~~ m. (approximate if not unpiled)
5. A. set in conc/rock has been placed m. bearing°M from Trig. Mast
 6. A. set in conc/soil has been placed m. bearing°M from Trig. Mast
 7. A. set in conc/soil has been placed m. bearing°M from Trig. Mast
 8. A. set in conc/rock has been placed m. bearing°M from Trig. Mast
 9. Connection to m. bearing°M
 10. Connection to m. bearing°M
 11. Connection to m. bearing°M
 12. Connection to m. bearing°M
 13. Diff. Ht. is m. ^{above}/_{below}
 14. Diff. Ht. is m. ^{above}/_{below}
 15. Diff. Ht. is m. ^{above}/_{below}
 16. Diff. Ht. is m. ^{above}/_{below}

Prepared by: **B.H.P. SURVEY DEPT.** Checked: **Noted on U.T.M. Card**

Co: **CAMDEN** / **WOLLONGONG**
Map Sheet: **9029-11-S**
Inspected by: **S.M.E.C.**
Authority: **S.M.E.C.**
Date: **9029-11-S**
Field Book: **Not to Scale**

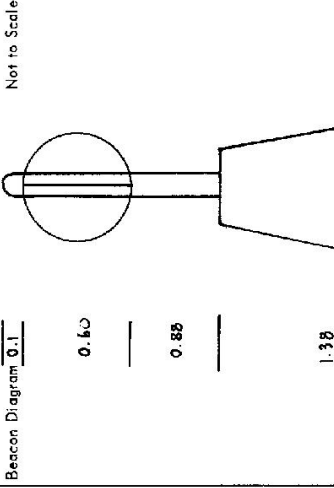

0.60

0.85

1.38

Date: **1-12-77** by **B.H.P.**

Record of Station **Rock**

Checked


STATION HURTI' (P) T.S. 10542

Owners Name... M.W.S. & D.B.

Address... SYDNEY


Current Occupant.....

Address.....

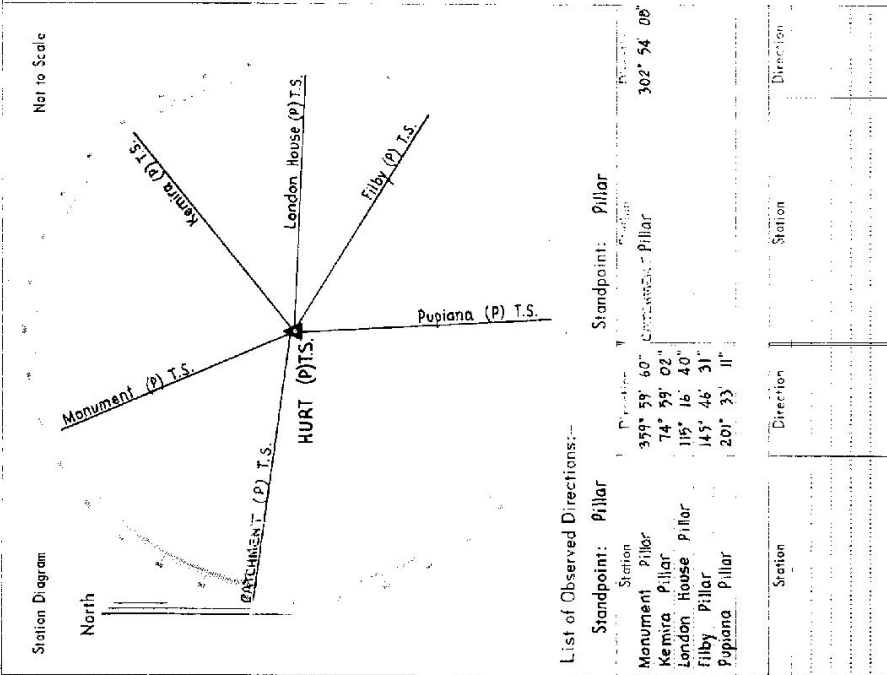

List of Observed Directions:-

Station	Direction	Station	Direction
Standpoint: Pillar		Standpoint: Pillar	
Monument Pillar	359° 58' 60"	Catchment Pillar	302° 54' 00"
Kemira Pillar	74° 59' 02"		
London House Pillar	115° 16' 40"		
Filby Pillar	145° 46' 31"		
Pupiana Pillar	201° 33' 11"		

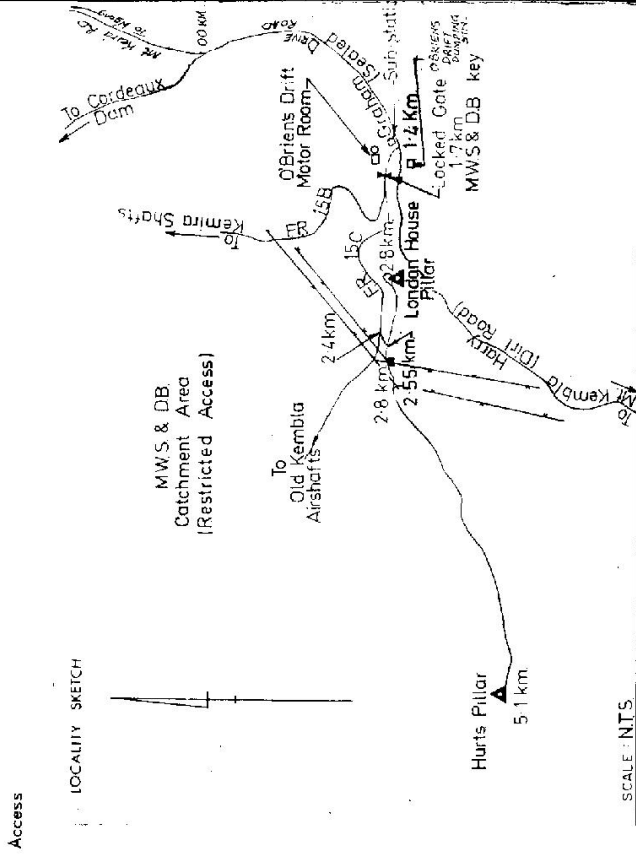

SCALE: N.T.S.