

CENTRAL MAPPING AUTHORITY
Department of Lands

Trigonometrical Survey of N.S.W.

RECONNAISSANCE and MAINTENANCE REPORT

STATION **KEMIRA (P)** T.S. **10543**

This Trig. Station has been:-

Co: **CAMDEN** Pht: **CORDEAUX**

Map Sheet: **WOLLONGONG** No: **9029-11-S**

Inspected by:

Date:

Authority **S.M.F.C.**

Field Book:

Beacon Diagram **0.1** Net to Scale

1. ~~Completely cleared to permit 360° vision to surrounding trig.~~
2. Cleared by lanes bearing **as per station diagram** from Trig. Mast

3. Trig. Mast & Vanes have been painted white & black respectively.

4. The Trig. was unpiled/not unpiled, dimensions now being: ~~Steel plug, Brass plug, Bolt, G.I. Pipe~~
Description of mark **Concrete Pillar** should be explicit, e.g. Steel plug, Brass plug, Bolt, G.I. Pipe

Height of mark **1.38** m above ~~rock/concrete~~ **rock** below ~~6 ft.~~
Height of Top Vanes to Top Mark **1.48** m. Diameter of Vanes (vertical) **0.60** m.

Height of ~~Corn~~ **0.60** m. ~~Diameter of Corn~~

~~Length of Mast~~ **1.38** m. (approximate if not unpiled)

5. A. ~~set in conc/rock has been placed~~ **set in conc/rock has been placed** **0.60** m. bearing **0.60** from Trig. Mast

6. A. ~~set in conc/soil has been placed~~ **set in conc/soil has been placed** **0.60** m. bearing **0.60** from Trig. Mast

7. A. ~~set in conc/soil has been placed~~ **set in conc/soil has been placed** **0.60** m. bearing **0.60** from Trig. Mast

8. A. ~~set in conc/rock has been placed~~ **set in conc/rock has been placed** **0.60** m. bearing **0.60** from Trig. Mast

9. Connection **to** **0.60** m. bearing **0.60**

10. Connection **to** **0.60** m. bearing **0.60**

11. Connection **to** **0.60** m. bearing **0.60**

12. Connection **to** **0.60** m. bearing **0.60**

13. Diff. Ht. **is** **0.60** m. ~~above~~ **below**

14. Diff. Ht. **is** **0.60** m. ~~above~~ **below**


15. Diff. Ht. **is** **0.60** m. ~~above~~ **below**

16. Diff. Ht. **is** **0.60** m. ~~above~~ **below**

Prepared by: **B.H.P. SURVEY DEPT.**

Noted on U.T.M. Card

Checked

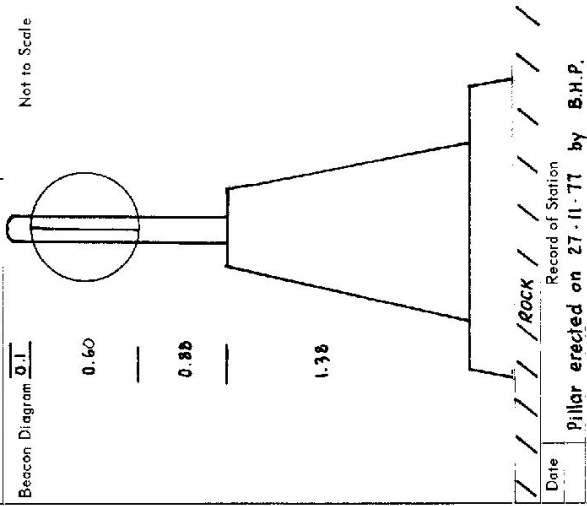

Date

Record of Station


Pillar erected on 27-11-77 by B.H.P.

Checked

STATION **KEMIRA (P)** T.S. 10543


Owners Name... **M.W.S. & D.B.**
 Address... **SYDNEY**
 Current Occupant.....
 Address.....

Not to Scale

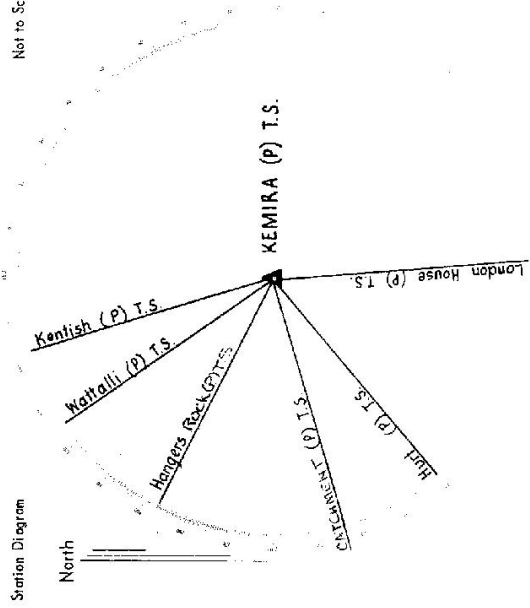

List of Observed Directions:

Station	Standpoint: Pillar	Direction	Station	Direction
Wattali Pillar	Hangers Rocks Pillar	359° 59' 60"	Hangers Rocks Pillar	333° 40' 34"
Kentish Pillar	London House Pillar	18° 01' 38"		
London House Pillar	Catchment Pillar	211° 29' 24"		
Hurt Pillar		265° 56' 34"		
Catchment Pillar		290° 20' 02"		

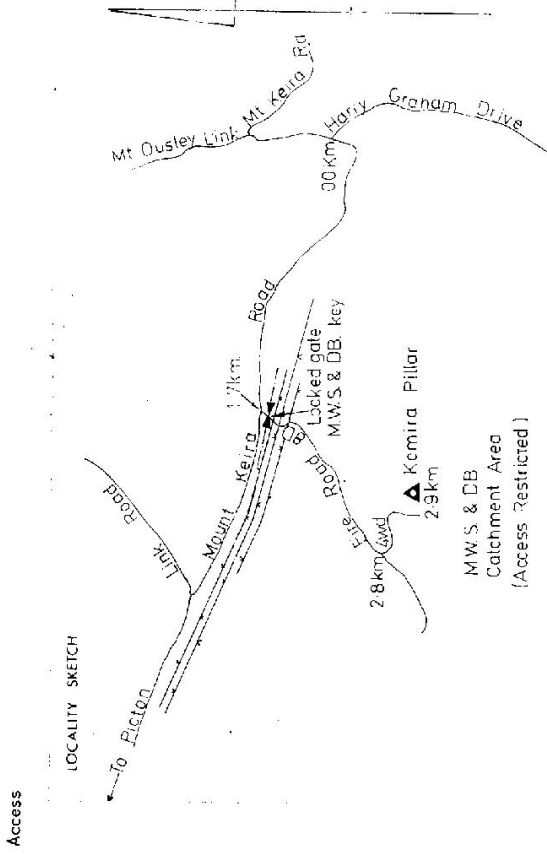

SCALE: NTS