

75 19

Department of Lands
Integral Survey of N.S.W.
RECONNAISSANCE and MAINTENANCE REPORT

STATION TS 10544 JUMPING ROCK [P]
Co: CAMDEN
Map Sheet: M111111.1
No: 6228-IV-5
Inspected by: IAN CARTER
Date: 20.5.80
Authority: INTERSTATE SURVEYS
Field Book: F10544

This Trig. Station has been:-
Note: Cross out word or words which do not apply


1. Completely cleared to permit 360° vision to surrounding trig.
2. Cleared by lanes bearing 36° and 220° from Trig. Mast
3. Trig. Mast & Vanes have been painted white & black respectively. ✓
4. The Trig. was ~~unpiled~~ not unpiled, dimensions are being.

Description of mark: CONCRETE PILLAR should be explicit, e.g. Steel plug, Brass plug, Bolt, Concrete Pillar
Height of mark: 1.37 m above G.L. ~~rock concrete~~
Height of Top Vanes to Top Mast/Top pillar plate: 1.47 m Diameter of Vanes (vertical): 6.0 m.
Height of Cap: m Diameter of Cap: m

- Length of Mast: 1.57 m. (approximate if not unpiled)
5. A. 34726 set in conc/rock has been placed/4 2.83° bearing 2.83° from Trig. Mast/pillar
 6. A. C. S. set in conc/soil has been placed/4 5.80° bearing 180° from Trig. Mast/pillar
 7. A. set in conc/soil has been placed/4 m. bearing m. from Trig. Mast/pillar
 8. A. set in conc/rock has been placed/4 m. bearing m. from Trig. Mast/pillar

9. Connection to m. bearing m.
10. Connection to m. bearing m.
11. Connection to m. bearing m.
12. Connection to m. bearing m.
13. Diff. Ht. is m. above/below
14. Diff. Ht. is m. above/below
15. Diff. Ht. is m. above/below
16. Diff. Ht. is m. above/below

Prepared by: IAN CARTER
Checked: IAN CARTER

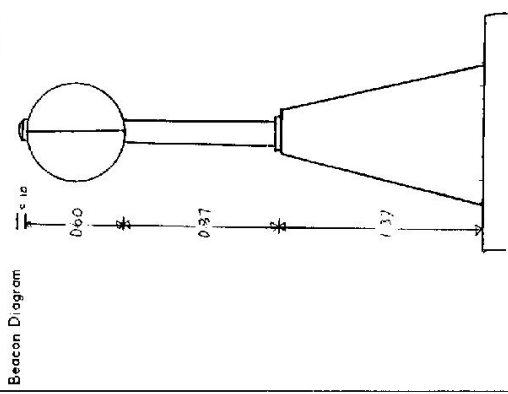

Date	Record of Station
	Mast Pillar Surveys Estimated

