

CENTRAL MAPPING AUTHORITY
Department of Lands

Trigonometrical Survey of N.S.W.

RECONNAISSANCE and MAINTENANCE REPORT

STATION MONUMENT (P) T.S. 10545

This Trig. Station has been:-


Note: Cross out word or words which do not apply

1. Completely cleared to permit 360° vision to surrounding Trigs.
2. ~~Cleared by stone-bearing~~..... from Trig. Mast
3. Trig. Mast & Vanes have been painted white & black respectively.
4. The Trig. was unpiled/not unpiled, dimensions now being: ~~.....~~

- Description of mark..... Concrete Pillar should be explicit, e.g. Steel plug, Brass plug, Bolt, G.I. Pipe
- Height of mark..... 1.38 m ^{above station} ~~below~~ concrete ~~rock~~ ^{above} ~~below~~ G.L.
- Height of Top Vanes to Top Mark..... 1.40 m. Diameter of Vanes (vertical)..... 0.60 m.
- Height of ~~Centre~~..... m. Diameter of ~~Centre~~..... m.
- Length of Mast..... m. (approximate if not unpiled)
5. A..... set in conc/rock has been placed..... m. bearing.....°M from Trig. Mast
 6. A..... set in conc/soil has been placed..... m. bearing.....°M from Trig. Mast
 7. A..... set in conc/soil has been placed..... m. bearing.....°M from Trig. Mast
 8. A..... set in conc/rock has been placed..... m. bearing.....°M from Trig. Mast
 9. Connection..... to..... m. bearing.....°M
 10. Connection..... to..... m. bearing.....°M
 11. Connection..... to..... m. bearing.....°M
 12. Connection..... to..... m. bearing.....°M
 13. Diff. Ht. is..... m. ^{above} ~~below~~
 14. Diff. Ht. is..... m. ^{above} ~~below~~
 15. Diff. Ht. is..... m. ^{above} ~~below~~
 16. Diff. Ht. is..... m. ^{above} ~~below~~

Prepared by: B.H.P. SURVEY DEPT. Checked: Nored on U.T.M. Card

Ce: CAMDEN
Map Sheet: WOLLONGONG
Inspected by:
Authority: S.M.E.C.
Date:
Field Book:
Net to Scale

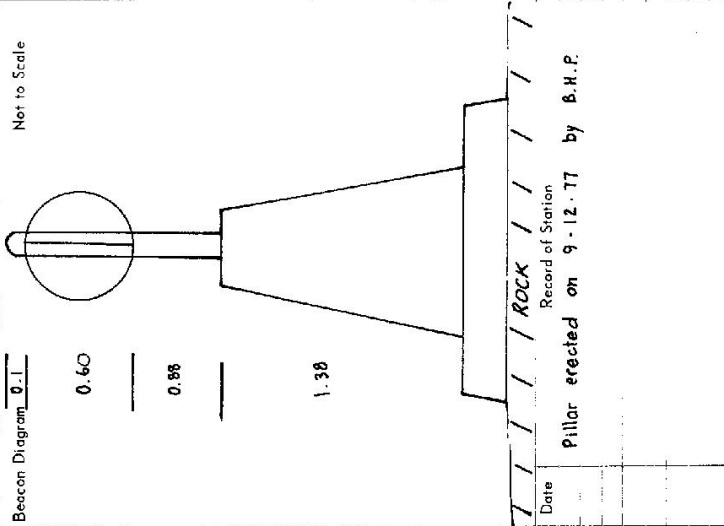

Date
Record of Station
Pillar erected on 9-12-77 by B.H.P.

Checked

STATION MONUM T (P) T.S. 10545

Owners Name: **M. W. S. & D. B.**

Address: **SYDNEY**


Current Occupant:

Address:

Access:


Not to Scale

Station Diagram

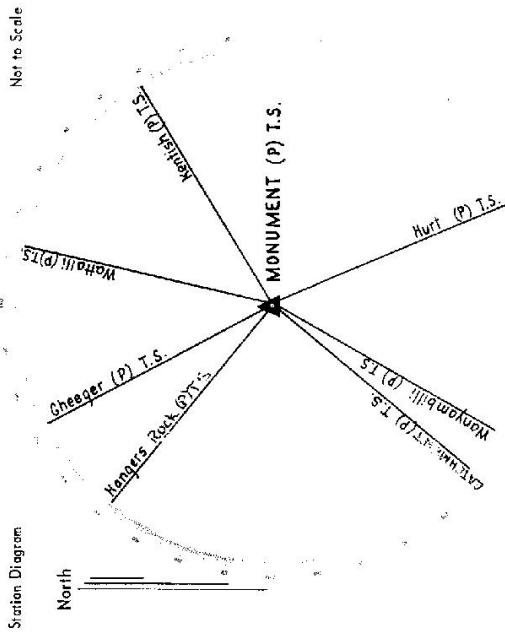

List of Observed Directions:

Station	Direction	Standpoint	Station	Direction
Kentish Pillar	359° 59' 60"	Pillar	Gheeger Pillar	275° 39' 24"
Hurst Pillar	98° 00' 03"	Pillar	Wonthaggi Pillar	315° 02' 03"
Wonthaggi Pillar	191° 35' 26"	Pillar		
EMERALD PILLAR	162° 01' 51"			
Hongers Rocks Pillar	251° 23' 06"			

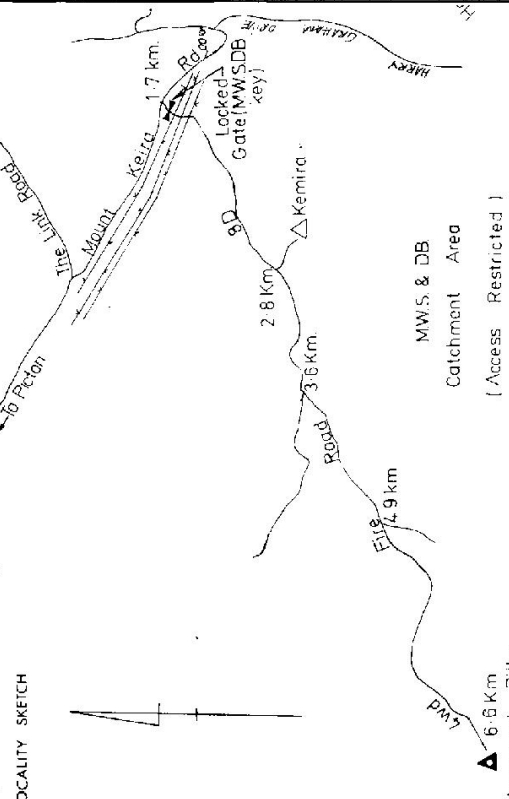

SCALE: N1S